

U.S. PUBLIC LAND SURVEY MONUMENT RECORD - GRANT COUNTY, WI

Section 28, Town 7 North Range 2 West, Town of Hickory Grove (a)



NOTE: This form is intended and designed to fulfill all requirements of the Wisconsin Administrative Code Chapter A-E 7.08, U.S. Public Land Survey Monument Record (3) (a) (b) (c) (d) (e) (f) (g) (h) (i).

CERTIFICATE: (i)

I, Aaron J. Austin, Wisconsin Professional Land Surveyor, do hereby certify that the corner location on this record was determined by me and/or under my direct supervision and that this U.S. Public Land Survey Monument Record is correct and complete to the best of my knowledge and belief.

Dated this 21st day of April, 2016.

Aaron J. Austin
 Aaron J. Austin, S-2922

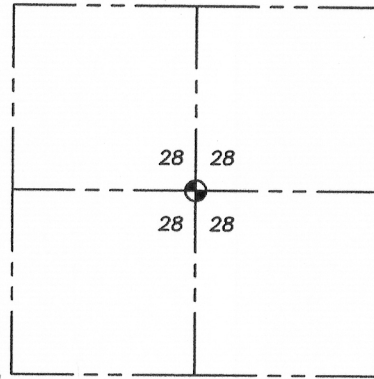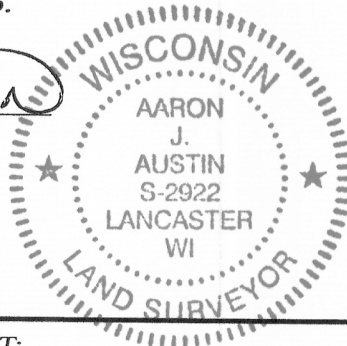

⊙ = CORNER LOCATION

Grant County Coordinates:
 NAD 83 (2011)
 Northing: 598,593.23
 Easting: 844,103.88

HISTORY OF CORNER ESTABLISHMENT:

1997-Larry Austin established the location at the intersection of East-West 1/4 and North-South 1/4 lines (no monument set) on a Survey filed in Book 1, Page 89.

2005-Laurence Schmit established the corner by the same method and set a 3/4" Rebar at the location on a Survey filed in Book 17, Page 96.

2012- Aaron Austin tied to the corner and found a 3/4" rebar on a Survey filed in Book 31, Page 7.


DESCRIPTION OF CORNER EVIDENCE FOUND: (b) (f) (g) (h)

I found a 3/4" rebar at the location established by Laurence Schmit. I set 4 witness corners after I verified it's location with E.D.M. and G.P.S. methods.

DESCRIPTION OF CORNER AND WITNESS MONUMENTS, references and accessories used to perpetuate the original or re-established location of this corner. (c) (d) (e)


Witnesses to corner location Shane Austin, Aaron Austin.

SKETCH:

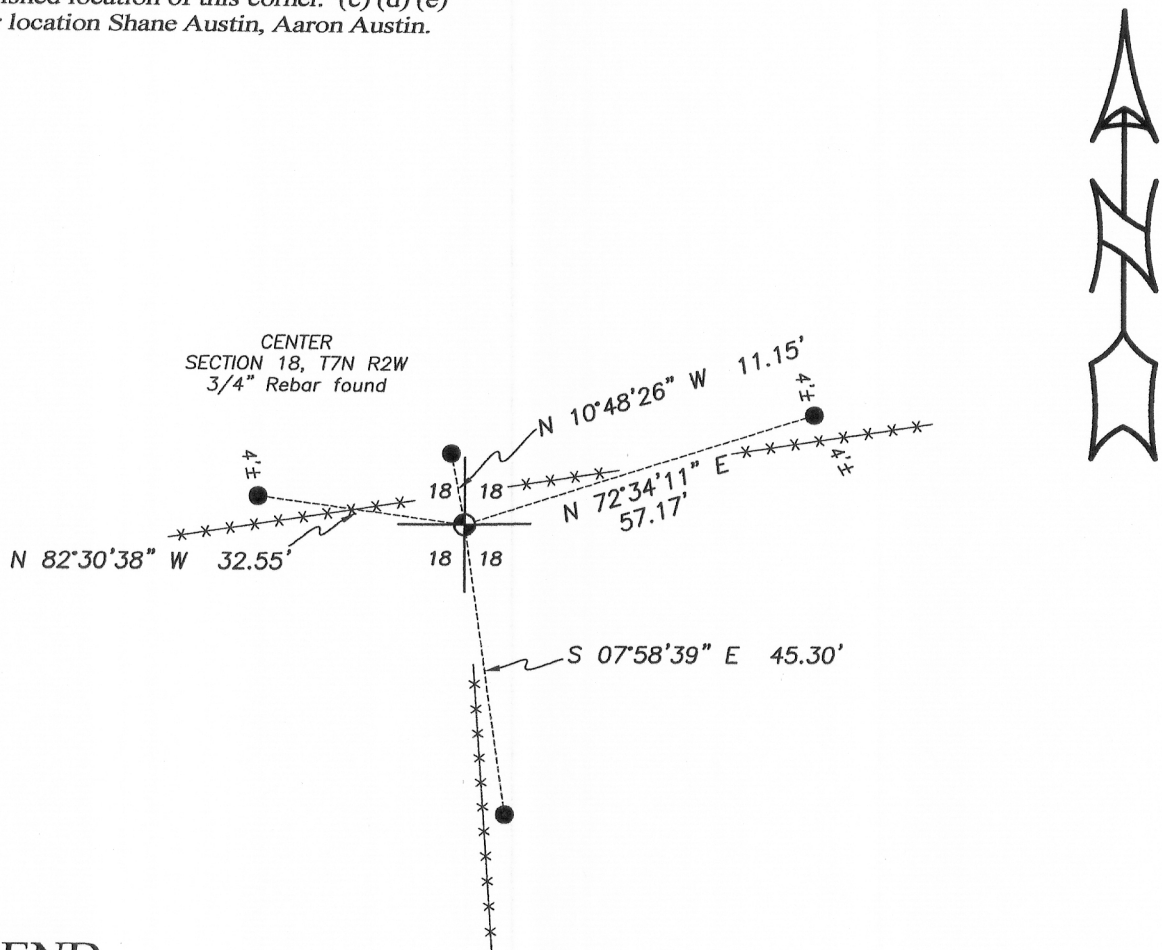

LEGEND

- ⊙ Section Corner—as designated
- 1/2" x 12" rebar set
- x-x- Approximate fence location

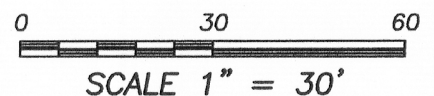

4211 HWY 81 E, LANCASTER, WI 53813
 PHONE: 608-723-6363 FAX: 608-723-6702

JOB NO: 16S012
 H:CRD\16s012
 H:\TIE\T7NR2W\54.5

FIELDBOOK: TDSR
 DRAWN BY: AJ AUSTIN
 CREW: SW AUSTIN

MAY 02 2016

96.5