

72096

U.S. PUBLIC LAND SURVEY MONUMENT RECORD - GRANT COUNTY, WI

Section 29, Town 7 North Range 2 West, Town of Hickory Grove (a)


NOTE: This form is intended and designed to fulfill all requirements of the Wisconsin Administrative Code Chapter A-E 7.08, U.S. Public Land Survey Monument Record (3) (a) (b) (c) (d) (e) (f) (g) (h) (i).

CERTIFICATE: (i)

I, Aaron J. Austin, Wisconsin Professional Land Surveyor, do hereby certify that the corner location on this record was determined by me and/or under my direct supervision and that this U.S. Public Land Survey Monument Record is correct and complete to the best of my knowledge and belief.

Dated this 27th day of June, 2019.

Aaron J. Austin
Aaron J. Austin, S-2922

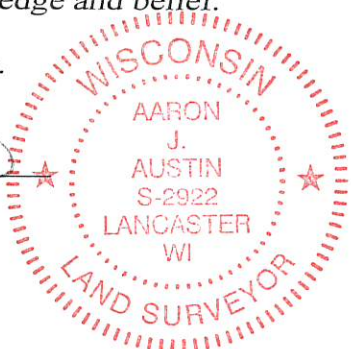

⊕ = CORNER LOCATION

Grant County Coordinates:
NAD 83 (2011)
Northing: 598,639.99
Easting: 841,429.67

HISTORY OF CORNER ESTABLISHMENT:

Original corner was set in 1832 by Sibley. Laurence Schmit set a 7/8" rebar with a Grant County cap and prepared a Survey Monument Record dated 9-20-2005.

DESCRIPTION OF CORNER EVIDENCE FOUND: (b) (f) (g) (h)

I found the monument set by Schmit along with two of his witness corners. I set two new witness corners after I verified the Monument's location with G.P.S. and E.D.M. methods.

DESCRIPTION OF CORNER AND WITNESS MONUMENTS, references and accessories used to perpetuate the original or re-established location of this corner. (c) (d) (e)

Witnesses to corner location Shane Austin, Owen Austin.
Drawn by: Owen Austin

SKETCH:

LEGEND

- ⊕ Section Corner—as designated
- 3/4" rebar found
- 3/4" x 18" rebar set
- ⊘ Existing utility pole
- x-x-x- Existing fence

