


Survey Monument Record

TYPE OF MONUMENT 3/4" x 24" IRON  
BAR SET AT CORNER

CORNER NO. 108  
 SECTION 28  
 TOWN 7N  
 RANGE 21W

FIELD BOOK: 97-34  
 PAGE \_\_\_\_\_

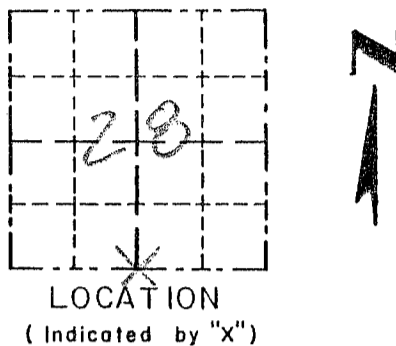

BASIS FOR MONUMENT LOCATION

(Use reverse side if necessary)

Show info such as: History of corner, with reference to Vol. and pg., dates, surveyor; exact description of monument replaced; if location computed, by taped or EDM traverse; landowner, remarks, etc.

CORNER SET IN 1832 BY HARVEY PARKE. NO RECORD OF CORNER FOUND SINCE ORIGINAL SURVEYS; CORNER WAS SET AT AN OCCUPIED LOCATION. VERIFIED THIS LOCATION USING EDM METHODS.

SEAL:



CERTIFIED CORRECT  
*Kenneth J. Rust*  
 Registered Land Surveyor  
 DATE: 12/31/97

TIE SKETCH

Show at least three (3) ties and monument

LEGEND

- ⊕ 3/4" x 24" IRON BAR SET
- 1/2" x 15" IRON BAR SET
- XX EXISTING FENCE

