
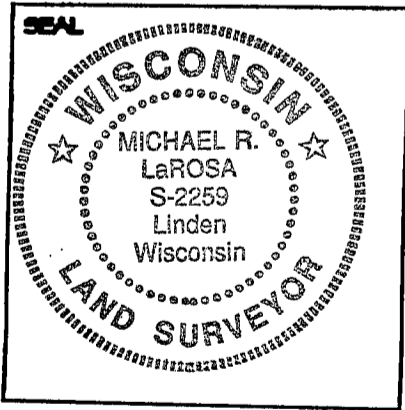


SECTION SUMMARY SHEET

SECTION 12 T 7 N R 2 W

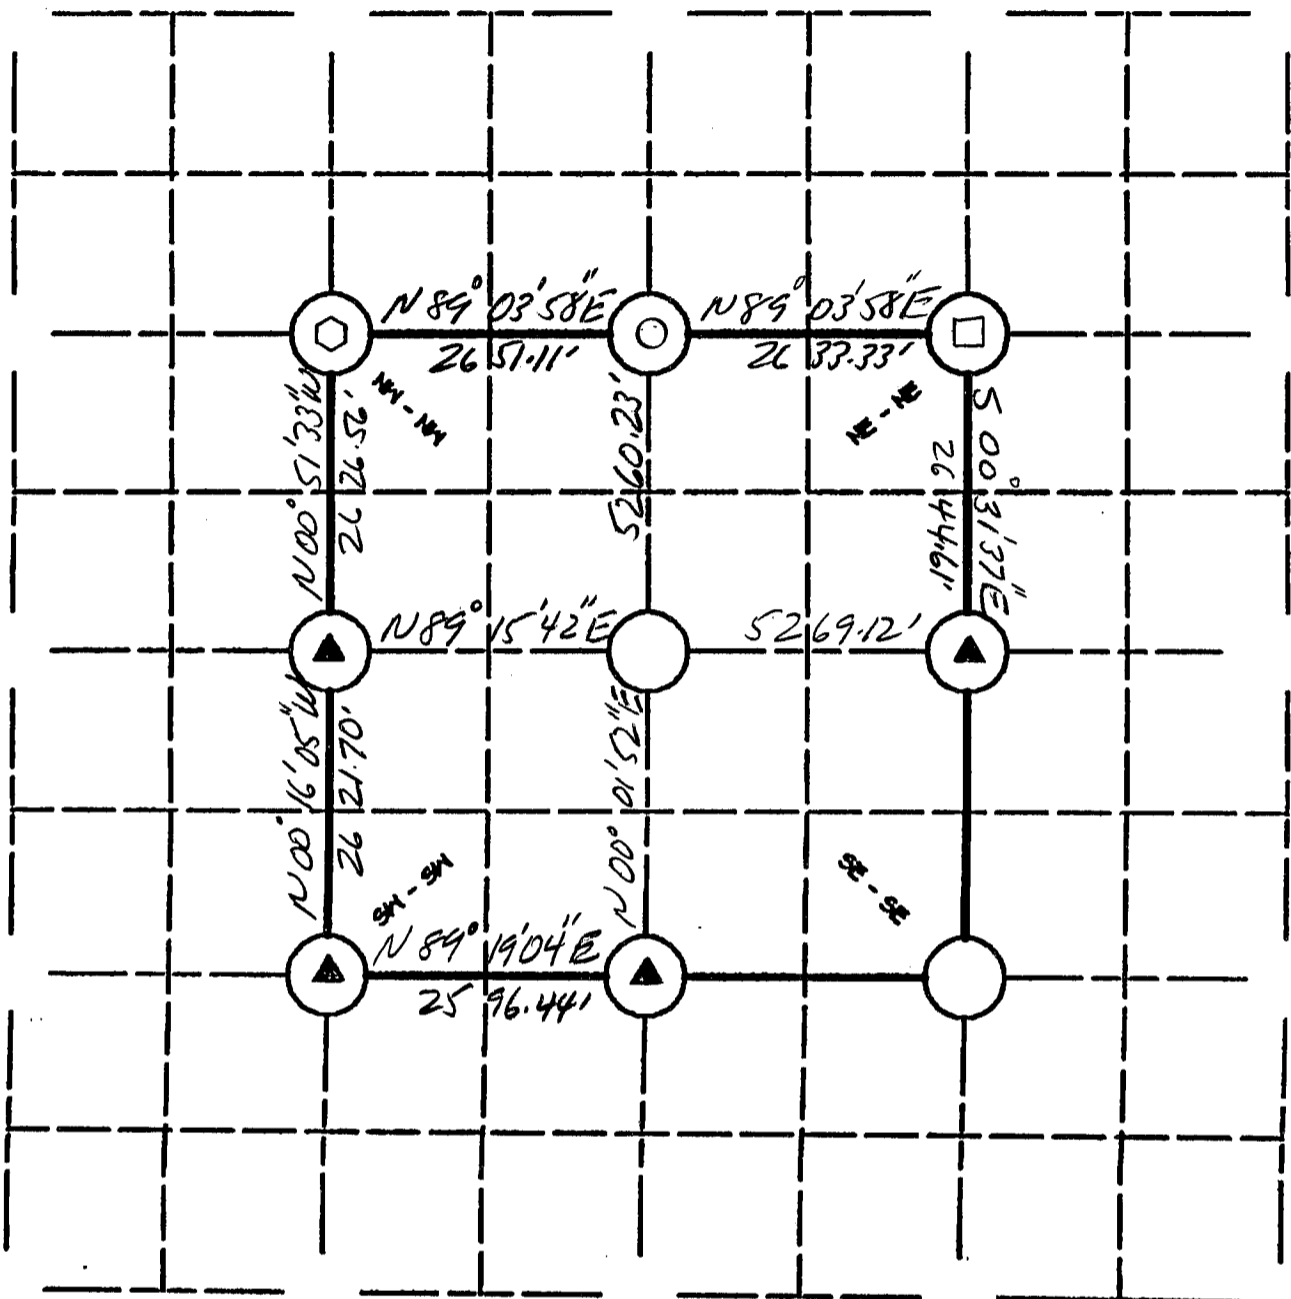

LEGEND:

- COUNTY MONUMENT SET 1" x 30" W/ALUM. CAP
- COUNTY MONUMENT FOUND
- OTHER(Specify) _____
- OTHER(Specify) 3/4" IRON ROD FOUND
- OTHER(Specify) 2" IRON PIPE FOUND
- OTHER(Specify) 1" IRON PIPE FOUND

BEARINGS REF. _____

4/21/2003
Michael R. LaRosa
 SIGNATURE DATE

Horiz. Datum	<input type="checkbox"/> NAD 21
	<input type="checkbox"/> NAD 83(11)
Units	<input type="checkbox"/> ENGLISH
	<input type="checkbox"/> Metric
Co-ordinate System	<input type="checkbox"/> Geodetic
	<input type="checkbox"/> State Plane(S. zone)
	<input checked="" type="checkbox"/> UTM County

The information provided in this box is not req'd, but requested to be provided if available to the surveyor preparing this sheet; otherwise provide reference in accordance with survey plat related to preparation of this sheet.

Place coordinates furnished adjacent to the corner(s) on section sketch above.

GRANT