


U.S. PUBLIC LAND SURVEY MONUMENT RECORD – GRANT COUNTY, WI
Summary of Section 25, Town 7 North, Range 2 West, Town of Hickory Grove

(40.075ch = 2644.95')
 (N 89°43'19" E 2616.84')
 N 89°39'04" E 2616.95'

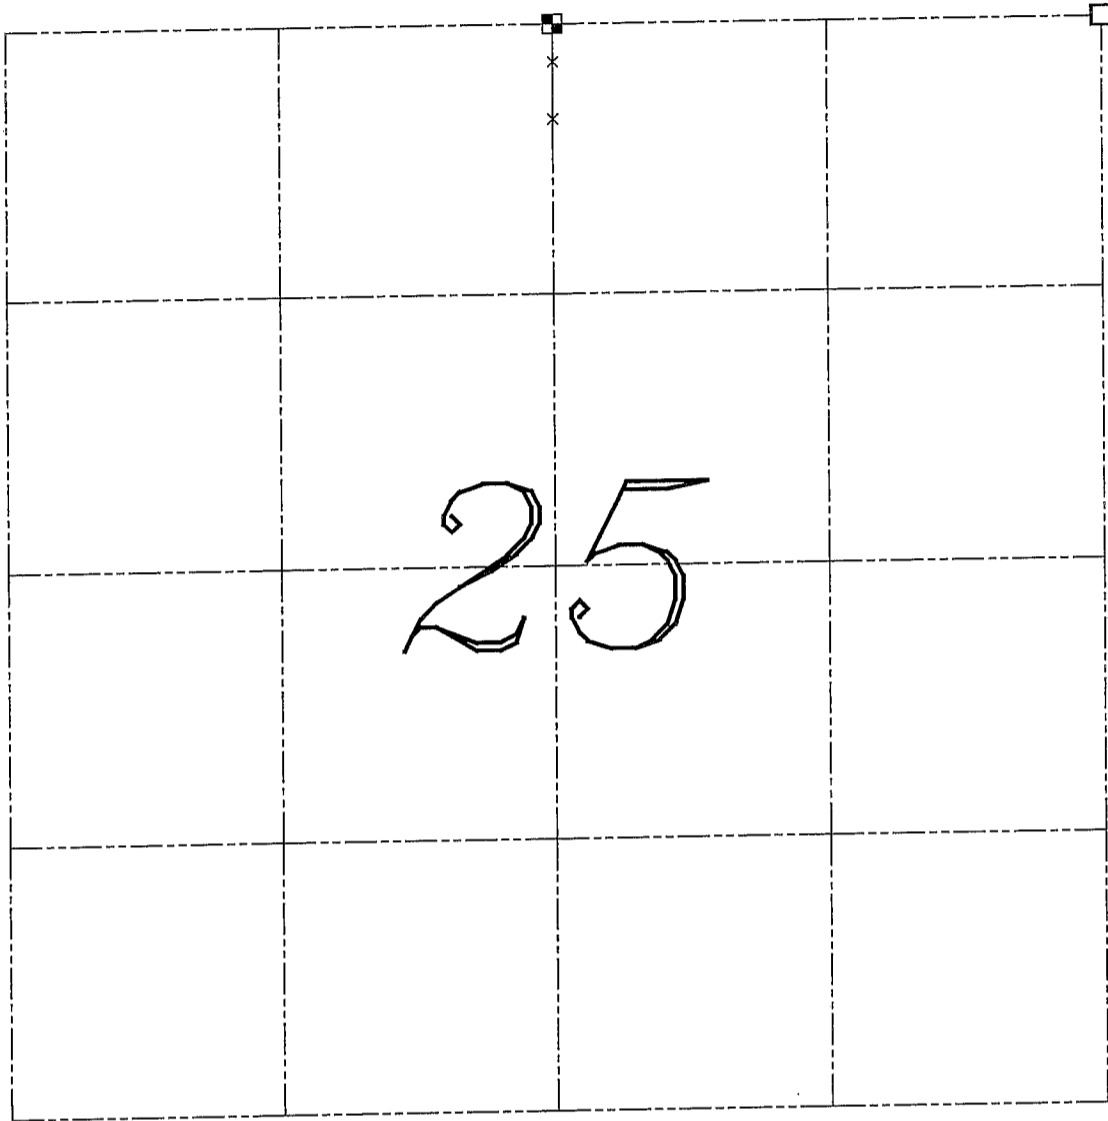


LEGEND

- No. 10 rebar found
- Aluminum Monument found with Grant County Aluminum Cap
- < > Recorded as
- x— Approximate location of existing fence

Relationship of all section corners to other section corners shall be shown hereon by bearing and distance or grid coordinates. Bearing reference shown below.

Dated this 6th day of October, 2003

Larry L. Austin
 Larry L. Austin S-1903

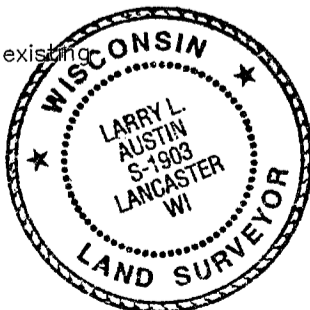

Bearings referenced to the North line of the NE Quarter of this Section, which is assumed to bear as shown hereon.

SKETCH NOT TO SCALE

AUSTIN ENGINEERING, LLC
 4211 HWY 81 EAST, LANCASTER, WI 53813
 PHONE 608-723-6363 FAX 608-723-6702

FIELDBOOK: TDSR, 2313
 G: \T7NR1W\29
 H: \TIE\T7NR2W\25SUM

CREW: BS-SB-SA-BD
 DRAWN BY: SW AUSTIN
 APPROVED: LL AUSTIN