

U. S. PUBLIC LAND SURVEY MONUMENT TIE SHEET - GRANT COUNTY WISCONSIN.


Section # 1, Town 7 North, Range 3 West, Town of Marion.

Certificate

I, Craig E Hardy, do hereby certify that the corner location on this record was determined by me and/or under my direct supervision and that this U.S. public land survey monument record is correct and complete to the best of my knowledge and belief.

Dated this 21st day of March, 2007.

Craig E Hardy
 Craig E Hardy, WI-RLS #2304

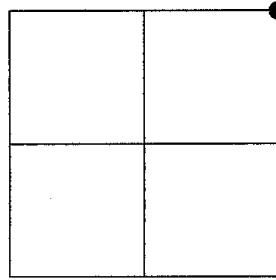

History of Corner Establishment

Corner was set in May of 1832. No other records exist at the county surveyor's office or tax lister's office.

Description of Corner Evidence Found:

I found a 1-1/2-inch dia. axle rod at the location of an existing fence. After an extensive excavation of the vicinity, no other evidence was recovered beyond fences of occupation. A GPS and EDM traverse survey of the occupation in four townships has led to the acceptance of this axle rod as the town corner. I set an aluminum county monument immediately adjacent to this found rod.

Description of Corner and Witness Monuments, references and accessories used to perpetuate the original or re-established location of this corner. Witnesses to corner location _____.

SKETCH:

