

# GRANT COUNTY

## Survey Monument Record

TYPE OF MONUMENT COUNTY MONUMENT SET

STATE PLANE COORDINATES: N \_\_\_\_\_  
E \_\_\_\_\_


ELEVATION — M.S.L. DATUM: \_\_\_\_\_

THETA ANGLE: \_\_\_\_\_

FIELD BOOK: 95-15

PAGE \_\_\_\_\_

CORNER NO. 4  
SECTION 2  
TOWN 7N  
RANGE 3W

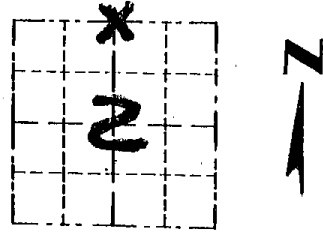


LOCATION  
(Indicated by "X")

### BASIS FOR MONUMENT LOCATION

(Use reverse side if necessary)

COUNTY MONUMENT SET  
ON THE SOUTH LINE OF  
THE SOUTHEAST 1/4 OF  
SECTION 35 — T8N, R3W — AT  
THE AVERAGE DISTANCE OF  
THE CLOSING CORNER DISTANCES  
AT THE NE COR. & NW COR.  
OF SECTION 2, FROM A  
1" IRON PIPE FOUND AT THE  
SOUTH 1/4 COR OF SEC 35 — T8N, R3W.

SEAL:

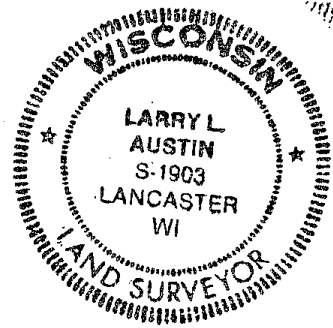

VERIFIED BY EDM TRAVERSE  
OF THE AREA.


CERTIFIED CORRECT

*Larry L. Austin*  
Registered Land Surveyor

DATE: 2/16/96

### TIE SKETCH

Show at least three (3) ties and monument

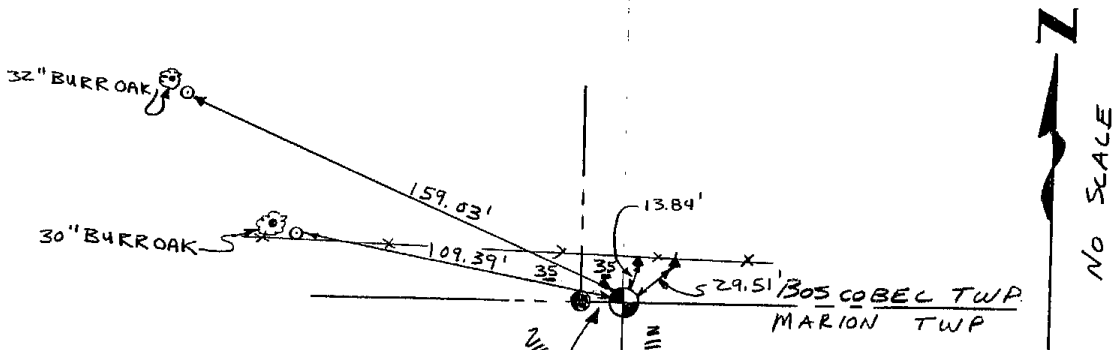

AVG CLOSING COR  
DISTANCE = 15.84'

#### LEGEND

- ⊕ COUNTY MONUMENT SET
- 1" IRON PIPE FND.
- ▲ 1/2" IRON BAR FND.
- 3/4" x 12" IRON BAR SET
- EXISTING FENCE