

U. S. PUBLIC LAND SURVEY MONUMENT TIE SHEET - GRANT COUNTY WISCONSIN.


Section # 1 , Town 7 North, Range 3 West, Town of
Marion.

Certificate

I, Craig E Hardy, do hereby certify that the corner location on this record was determined by me and/or under my direct supervision and that this U.S. public land survey monument record is correct and complete to the best of my knowledge and belief.

Dated this 21st day of March, 2007.

Craig E Hardy
Craig E Hardy, WI-RLS #2304

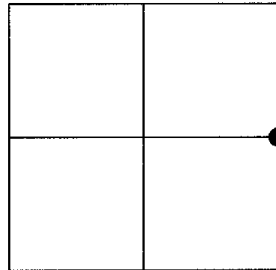

History of Corner Establishment

The original corner was set in 1833. No other records exist at the county tax office or county surveyor's office.

Description of Corner Evidence Found:

I found no evidence of the original corners beyond fence lines of occupation. I re-established this monument based on fence occupation and a GPS and EDM survey of property fences in the section on lands owned by Ole Seim Jr., Lloyd Hardy, and Doug Zimpel.

Description of Corner and Witness Monuments, references and accessories used to perpetuate the original or re-established location of this corner.

Witnesses to corner location _____

SKETCH:

