


Survey Monument Record

TYPE OF MONUMENT 3/4" IRON BAR FND
STATE PLANE COORDINATES: N
E
ELEVATION - M.S.L. DATUM:
THETA ANGLE:
FIELD BOOK: 95-15
PAGE

CORNER NO. 23
SECTION 2
TOWN 7N
RANGE 3W

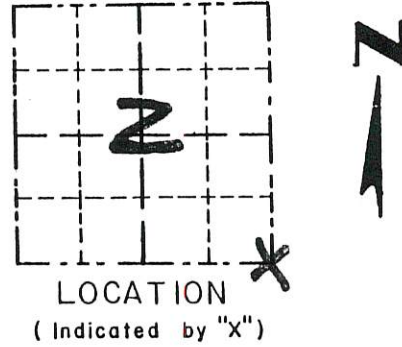

BASIS FOR MONUMENT LOCATION

(Use reverse side if necessary)

Show info such as: History of corner, with reference to Vol. and pg., dates, surveyor; exact description of monument replaced; if location computed, by taped or EDM traverse; landowner, remarks, etc.

SEAL:

FOUND AND ACCEPTED
A 3/4" IRON BAR AT
AN OCCUPIED FENCE
CORNER.

VERIFIED BY EDM TRAVERSE
OF THE AREA

THE ORIGINAL CORNER WAS SET
BY DARKE IN 1833



CERTIFIED CORRECT

Signature of Larry L. Austin
Registered Land Surveyor

DATE: 2/16/96

TIE SKETCH

Show at least three (3) ties and monument

