

GRANT COUNTY CERTIFIED LAND CORNER


CORNER NUMBER 106

CERTIFICATE:

I, Larry L. Austin, do hereby certify that I found occupational evidence of the North 1/4 corner of Section 34, Town 7 North, Range 3 West, of the 4th Principal Meridian, and I re-established said corner according to the Wisconsin statutes as shown and described hereon.

Dated this 25th day of October, 2000

Larry L. Austin
Larry L. Austin S-1903

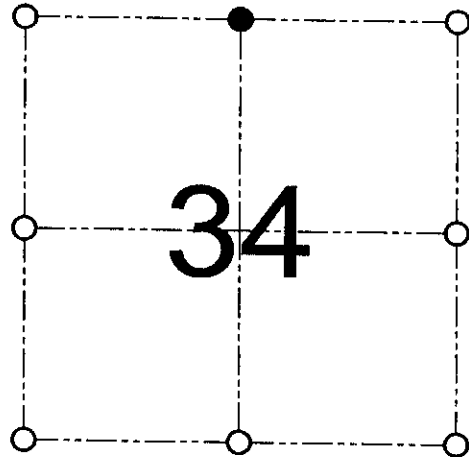

● = CORNER LOCATION

NORTH 1/4 CORNER OF
SECTION 34, T 7 N R 3 W
TOWN OF MARION

HISTORY OF ORIGINAL CORNER ESTABLISHMENT:

Corner was originally set in 1833 by Robert Parke.
No other record of the corner was found.

DESCRIPTION OF CORNER EVIDENCE FOUND:

I reset the corner based on occupational evidence.
I verified this location using EDM & GPS methods.

DESCRIPTION OF CORNER AND WITNESS MONUMENTS, references and accessories used to perpetuate the original or re-established location of this corner

WITNESS TO THE CORNER LOCATION: SHELBY BLINDERT & BOBBY SEDGWICK

SKETCH:

