

# GRANT COUNTY CERTIFIED LAND CORNER


**CERTIFICATE:**

I, LARRY L. AUSTIN, DO HEREBY CERTIFY THAT ON 22nd DAY OF OCTOBER, 1999, I FOUND EVIDENCE OF THE EAST 1/4 CORNER OF SECTION 36, TOWN 7 NORTH, RANGE 3 WEST, OF THE FOURTH PRINCIPAL MERIDIAN, AND I RE-ESTABLISHED SAID CORNER ACCORDING TO THE WISCONSIN STATUTES AS SHOWN AND DESCRIBED HEREON.

DATED THIS 27th DAY OF OCTOBER, 1999

*Larry L. Austin*  
LARRY L. AUSTIN S-1903

CORNER NUMBER 120

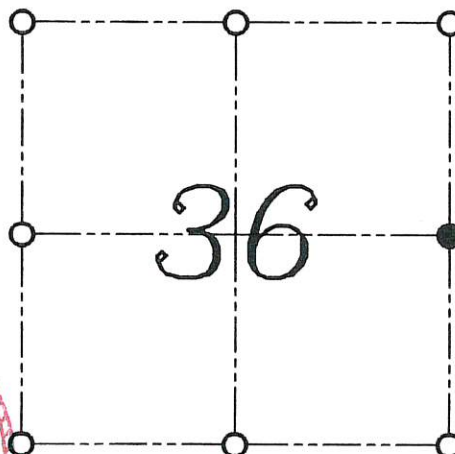

● = CORNER LOCATION  
EAST 1/4 CORNER OF  
SECTION 36, T 7 N R 3 W  
TOWN OF MARION



SEAL

**HISTORY OF ORIGINAL CORNER ESTABLISHMENT:**

CORNER WAS SET IN 1832 BY SIBLEY. NO OTHER RECORD OF THE CORNER WAS FOUND.

**DESCRIPTION OF CORNER EVIDENCE FOUND:**

I RESET THE CORNER AT THE PROPORTIONED OFFSET FROM RECORDED WEST 1/4 OF SECTION 31, T7N R2W. VERIFIED THIS LOCATION USING E.D.M. AND G.P.S. METHODS.

**DESCRIPTION OF CORNER AND WITNESS MONUMENTS, REFERENCES AND ACCESSORIES USED TO PERPETUATE THE ORIGINAL OR RE-ESTABLISHED LOCATION OF THIS CORNER:**  
WITNESS TO THE CORNER LOCATION: BOBBY SEDGWICK ; SHELBY BLINDERT

**SKETCH:**

