


GRANT COUNTY

Section Summary

$\frac{4}{SECTION} - \frac{T7N}{TOWN} - \frac{R3W}{RANGE}$

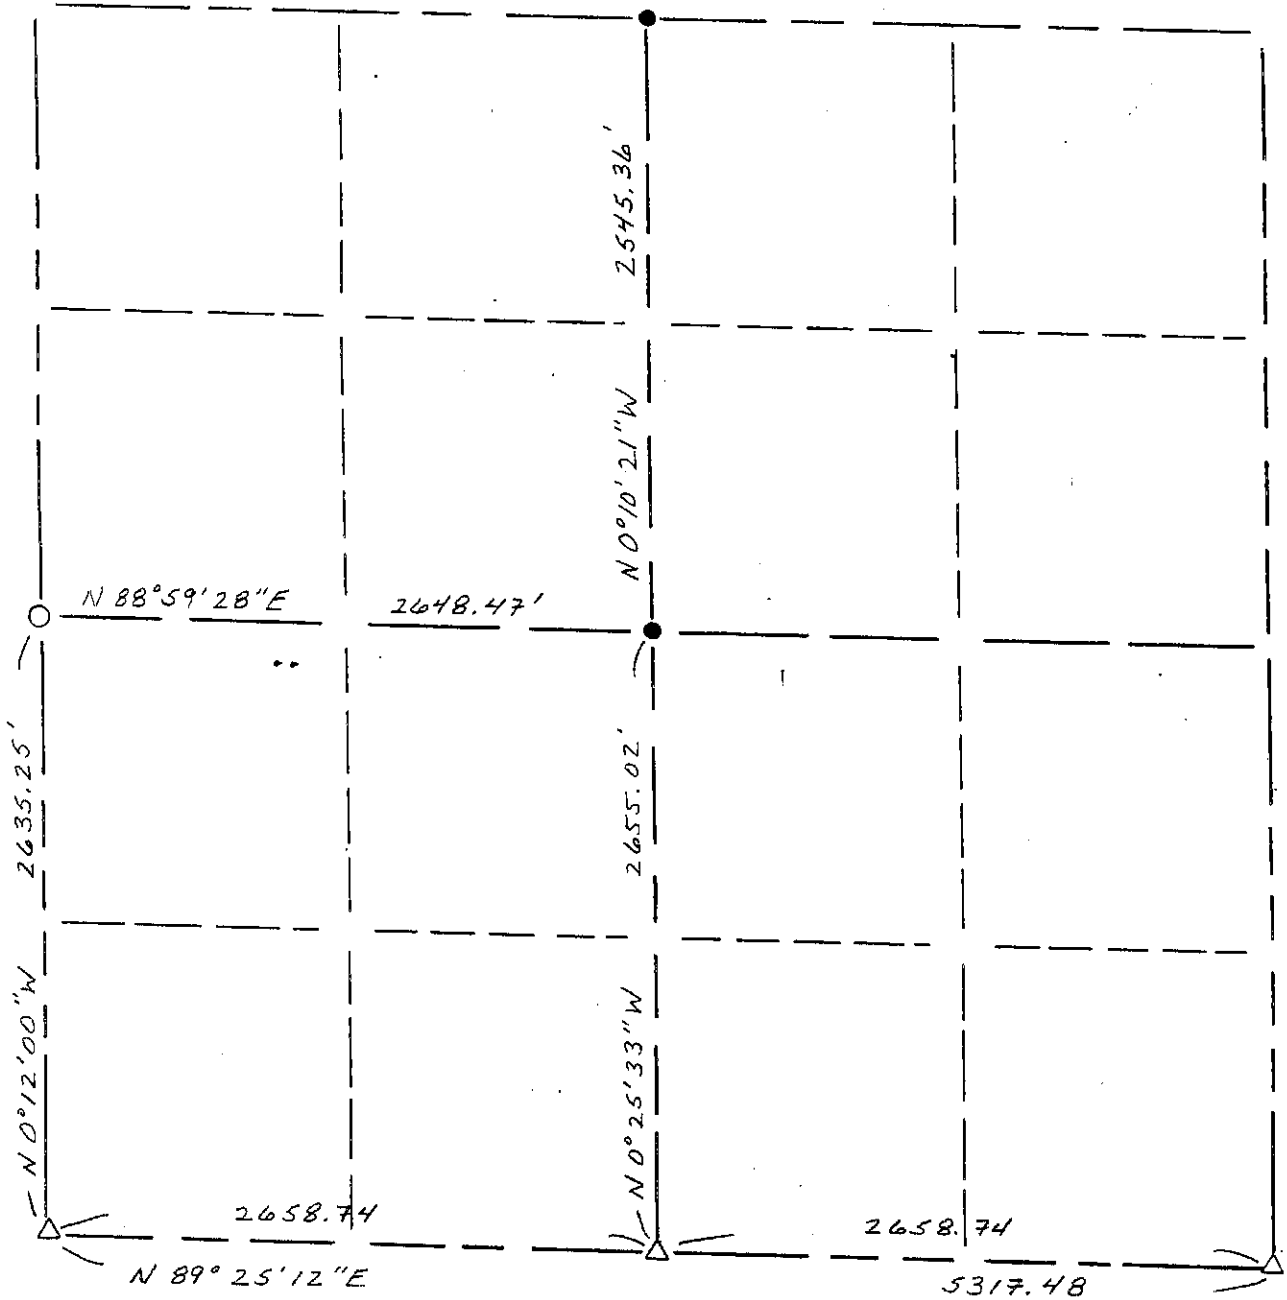

LEGEND

- Δ COUNTY MONUMENT
- \square STONE OR CONCRETE MONUMENT
- \bullet OTHER (specify) $\frac{5}{8}$ " dia. rebar - fd.
- \circ $\frac{3}{4}$ " dia. rebar - fd.

NOTE:

Relationships of all section corners to other section corners shall be shown hereon by bearing and distance or grid coordinates

Show or describe bearing reference

