


SECTION CORNER TIE SHEET INDEX

T. 7 N., R. 4 W

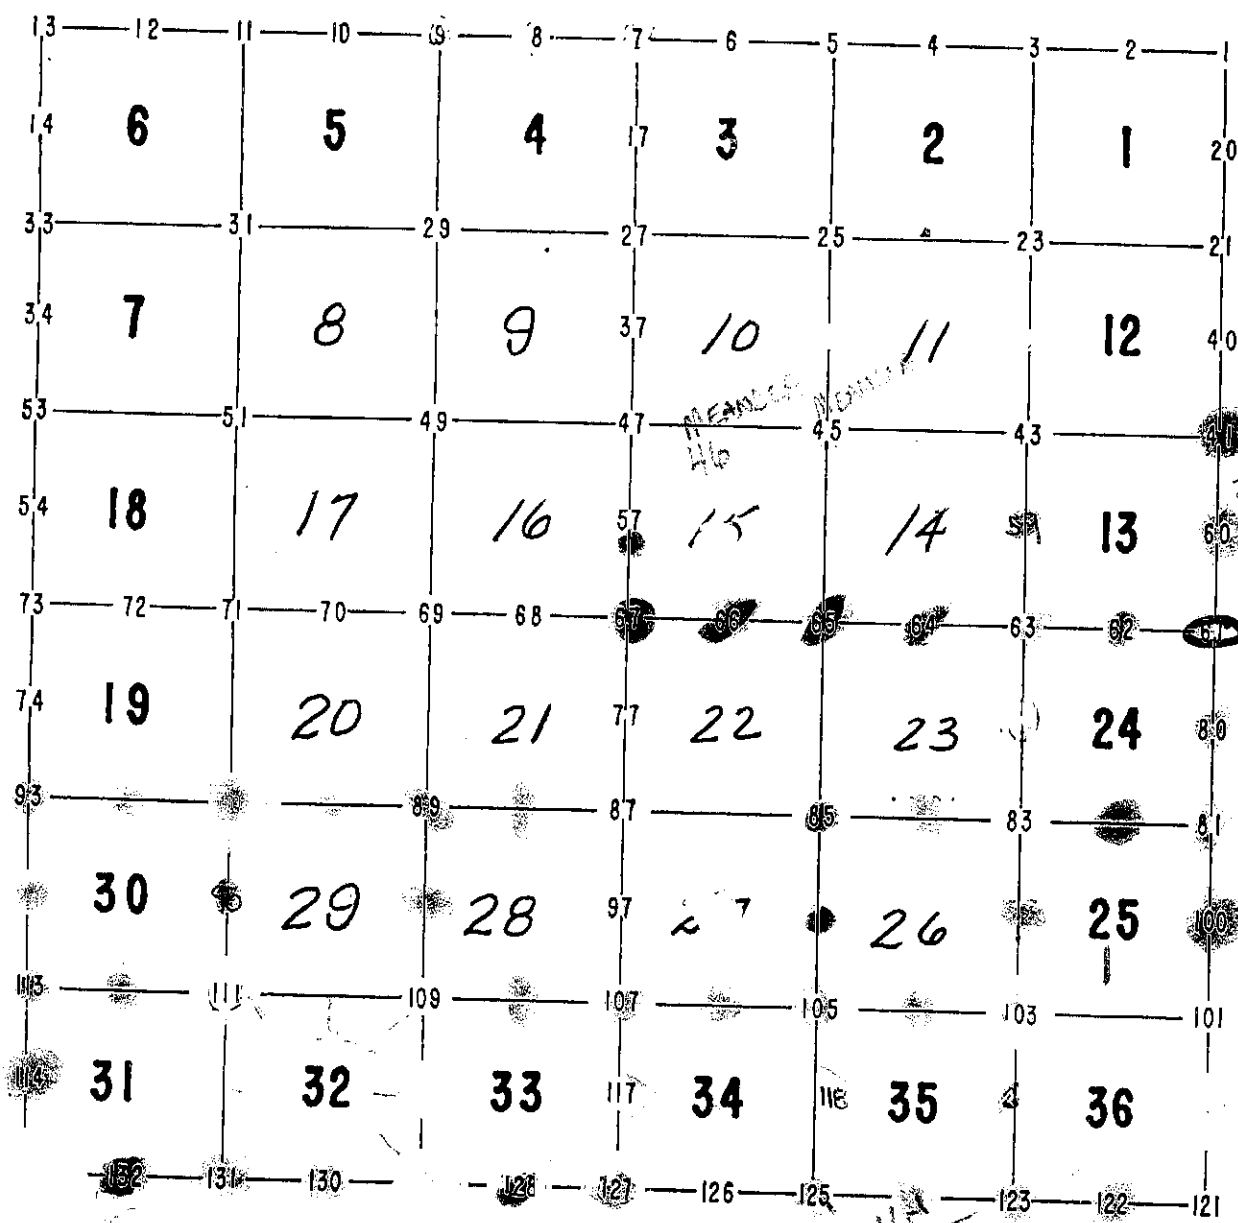

59-1-06

2/34

NW 1/3 61775-11
 NB 61775-11

18