

# GRANT COUNTY CERTIFIED LAND CORNER


CORNER NUMBER 41

**CERTIFICATE:**


I, Larry L. Austin, do hereby certify that on the 8th day of February, 2000, I found evidence of the Northeast corner of Section 13, Town 7 North, Range 4 West, of the 4th Principal Meridian, and I re-established said corner according to the Wisconsin statutes as shown and described hereon.

Dated this 16th day of February, 2000

*Larry L. Austin*  
Larry L. Austin S-1903

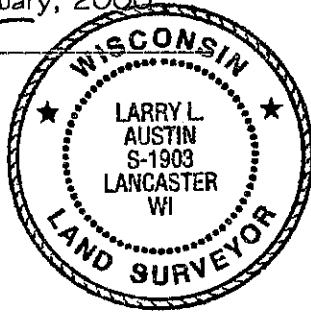

SEAL

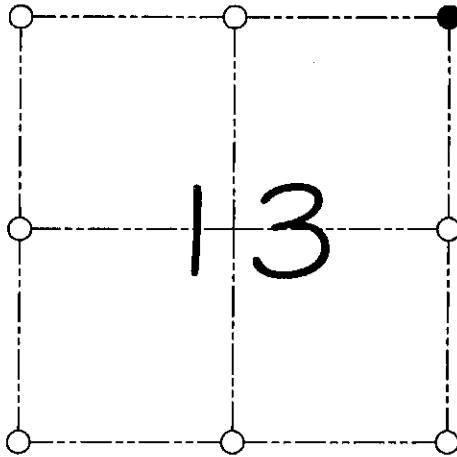

● = CORNER LOCATION  
**NORTHEAST CORNER OF  
SECTION 13, T 7 N R 4 W  
TOWN OF WOODMAN**

**HISTORY OF ORIGINAL CORNER ESTABLISHMENT:**

Corner was originally set in 1832 by Sibley.  
No other record of the corner was found.

**DESCRIPTION OF CORNER EVIDENCE FOUND:**

I found an existing 1" iron bar and accepted it's location  
after an E.D.M. and G.P.S. traverse of the area.

**DESCRIPTION OF CORNER AND WITNESS MONUMENTS, references and accessories used to perpetuate the original or re-established location of this corner**  
WITNESS TO THE CORNER LOCATION: SHANE AUSTIN & SHELBY BLINDERT

**SKETCH:**

LEGEND

- Number 8 Iron bar found
- Number 4 by 24" rebar set with red plastic cap
- ×× Existing fence location

