

U.S. PUBLIC LAND SURVEY MONUMENT RECORD - GRANT COUNTY, WI

Section 34, Town 7 North Range 4 West, Town of Woodman (a)



NOTE: This form is intended and designed to fulfill all requirements of the Wisconsin Administrative Cod. Chapter A-E 7.08, U.S. Public Land Survey Monument Record (3) (a) (b) (c) (d) (e) (f) (g) (h) (i). An additional sheet may be added if necessary to conform with said requirements.

CERTIFICATE: (i)
I, Aaron J. Austin, Wisconsin Professional Land Surveyor, do hereby certify that the corner location on this record was determined by me and/or under my direct supervision and that this U.S. Public Land Survey Monument Record is correct and complete to the best of my knowledge and belief.

Dated this 8th day of June, 2016.

Aaron J. Austin
Aaron J. Austin, S-2922

Grant County Coordinates
NAD 83 (2011) WISCORS
Northing: 593,476.72
Easting: 783,290.51

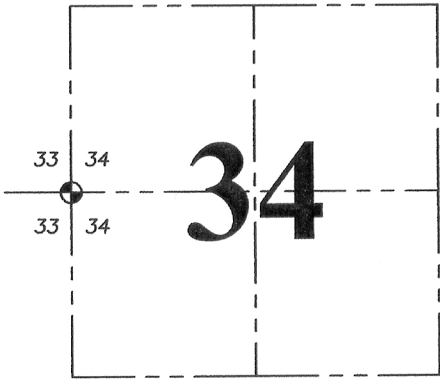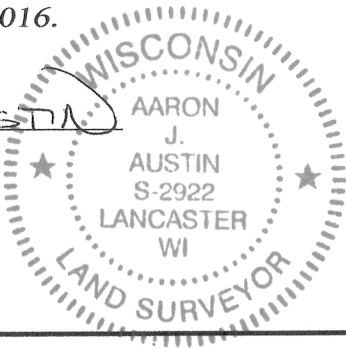

● = CORNER LOCATION

HISTORY OF CORNER ESTABLISHMENT:



1833-Harvey Parke set the original corner.
1979-Robert Lampman reset the corner on a Survey filed in Book 7, Page 24.
1998-Talarczyk found Lampman's corner and prepared a U.S. Public Land Survey Monument Record for the corner.

DESCRIPTION OF CORNER EVIDENCE FOUND: (b) (f) (g) (h)

The monument could not be recovered. I reset the corner from 2 found witness corners and set two additional witness corners after I verified its location with E.D.M. and G.P.S. methods.

DESCRIPTION OF CORNER AND WITNESS MONUMENTS, references and accessories used to perpetuate the original or re-established location of this corner. (c) (d) (e) Witnesses to corner location Shane Austin.

SKETCH:

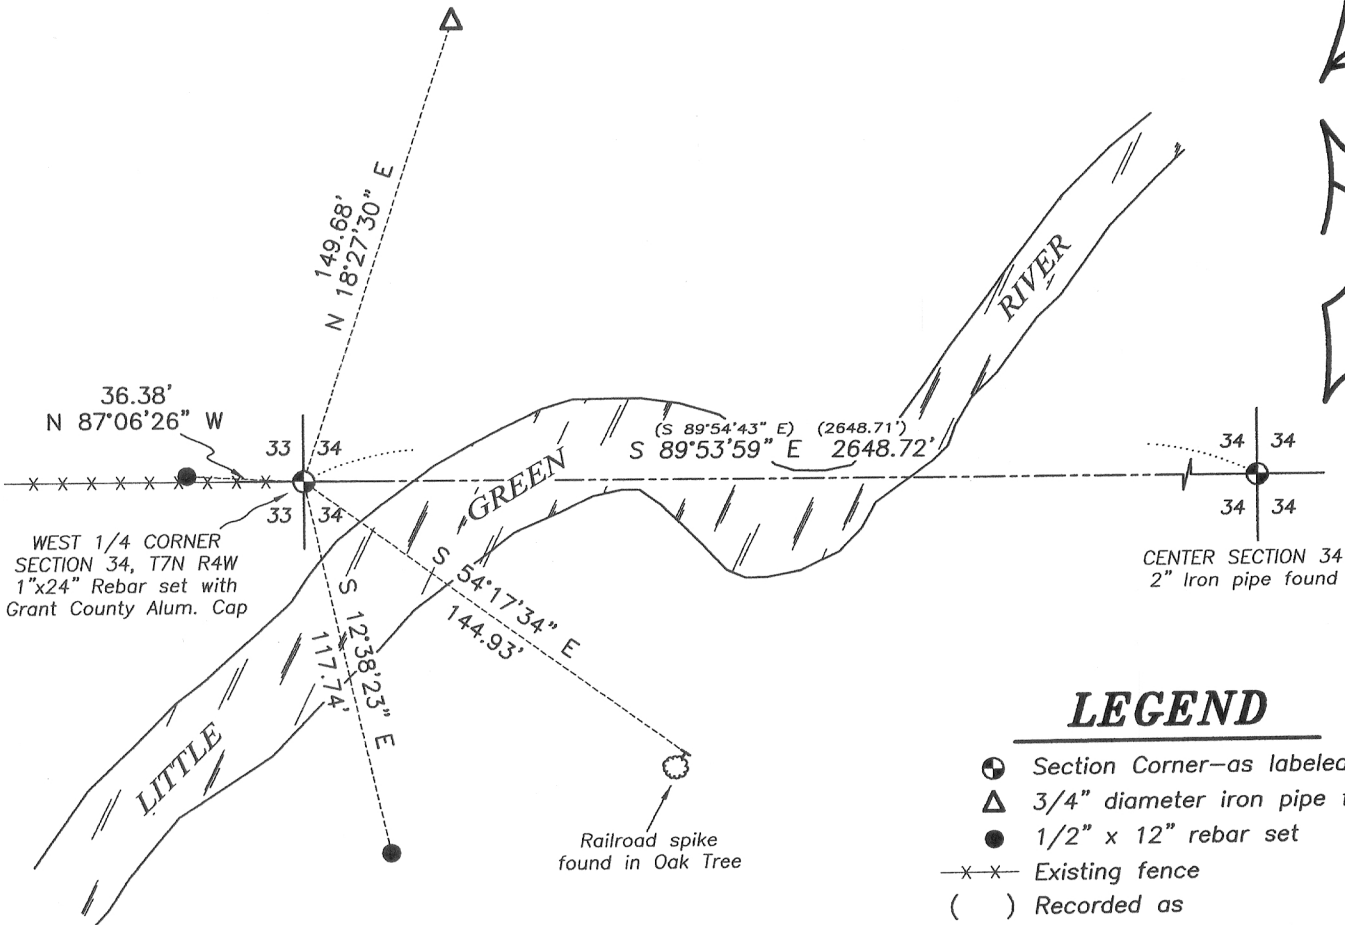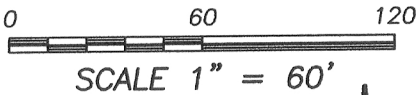

CENTERLINE
HIGHWAY #133

REC'D FEB 11 1996

U. S. PUBLIC LAND SURVEY MONUMENT RECORD


INSTRUCTIONS:

This record shall show the location of the corner and shall include all of the following nine elements (a through i).

- (a) Identify the corner by reference to the U.S. public land survey system.

▲ = Corner monument restored.

The West 1/4 corner of Section 34,
Town 7 North, Range 4 West, Town of
Woodman, Grant County, Wisconsin.

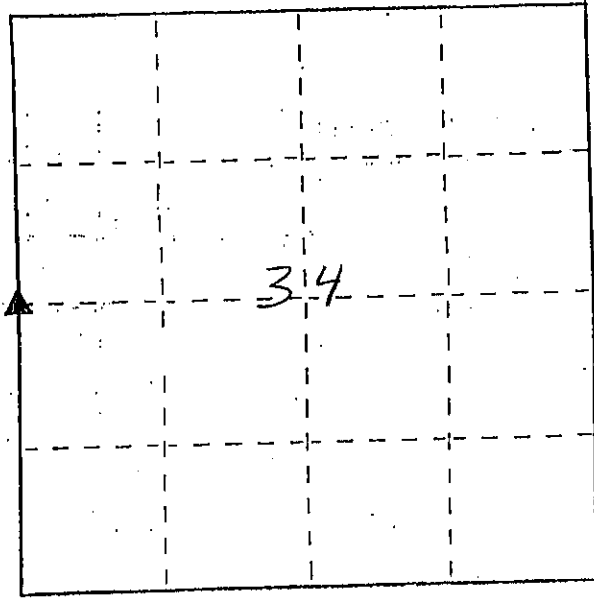

- (b) Describe any record evidence, monument evidence, occupational evidence, testimonial evidence or any other material evidence you considered, and whether the monument was found or placed.

Found and accepted a 2" iron pipe set by Robert M. Lampman in 1979.

- (c) In the plan view drawing below, provide reference ties to at least 4 witness monuments, or, if the location is within a municipality, to at least 2 witness monuments. (Witness monuments shall be made of concrete, natural stone, iron or other equally durable material.) Describe witness monuments.

- (d) Show a plan view drawing depicting the relevant monuments and reference ties which is sufficient in detail to enable accurate relocation of the corner monument if the corner monument is disturbed. Indicate north.


LEGEND:



2" IRON PIPE 1/4 SECTION CORNER FOUND.

● 3/4" x 24" IRON PIPE SET.

☼ RAILROAD SPIKE IN TREE
SCALE: 1" = 60'

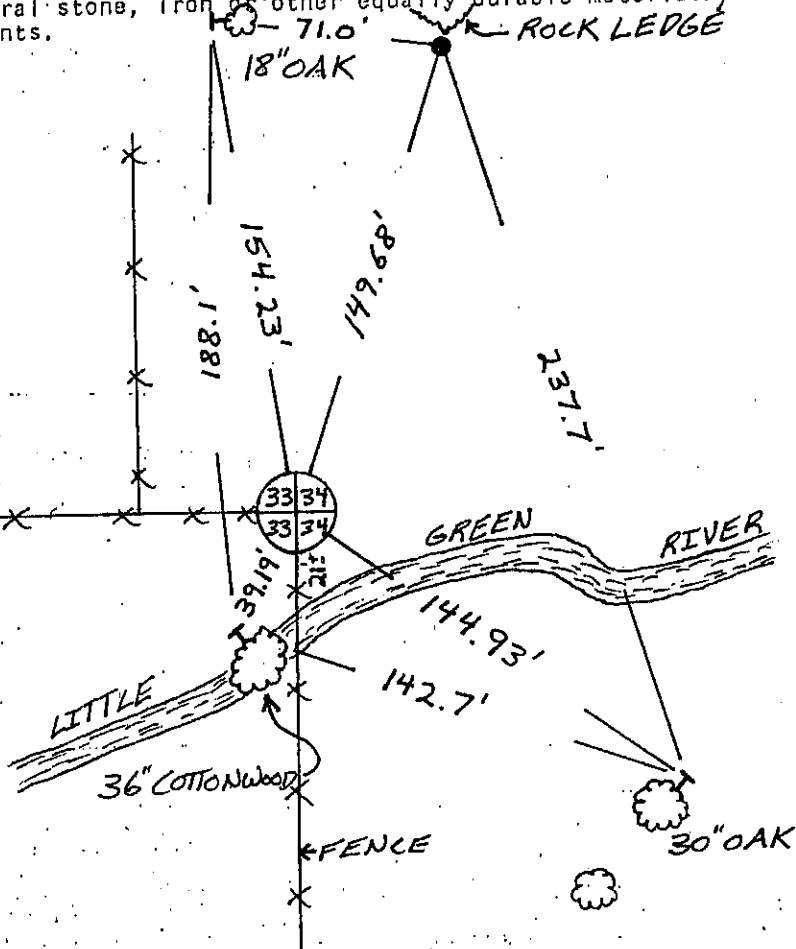

- (e) Describe any material discrepancy between the location of the corner as restored or reestablished and the location of that corner as previously restored or reestablished by distance and direction. Show the discrepancy on the plan view drawing under (d), above. Show the distances between the corner as previously restored or reestablished and (1) the corner as restored or reestablished, and (2) to at least 2 of the witness monuments shown on the drawing in (d), above.


None

- (f) Was the corner restored through acceptance of (1) an obliterated evidence location, or, (2) a found perpetuated location?

A found perpetuated location.

- (g&h) Was the corner reestablished through lost corner proportionate methods? If so, show the method, including the directions and distances to other public land survey corners used as evidence or used for proportioning in determining the corner location?

No

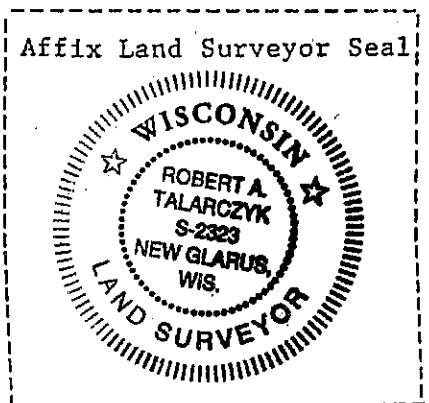

- (i) I, Robert A. Talarczyk
(type or print name) certify that the corner location shown on this record was determined by me or under my direction and control and that this U.S. Public Land Survey Monument Record is correct and complete to the best of my knowledge and belief.

Robert A. Talarczyk 01/19/98
Date