


SECTION CORNER TIE SHEET INDEX

T. 8 N., R. 1 W

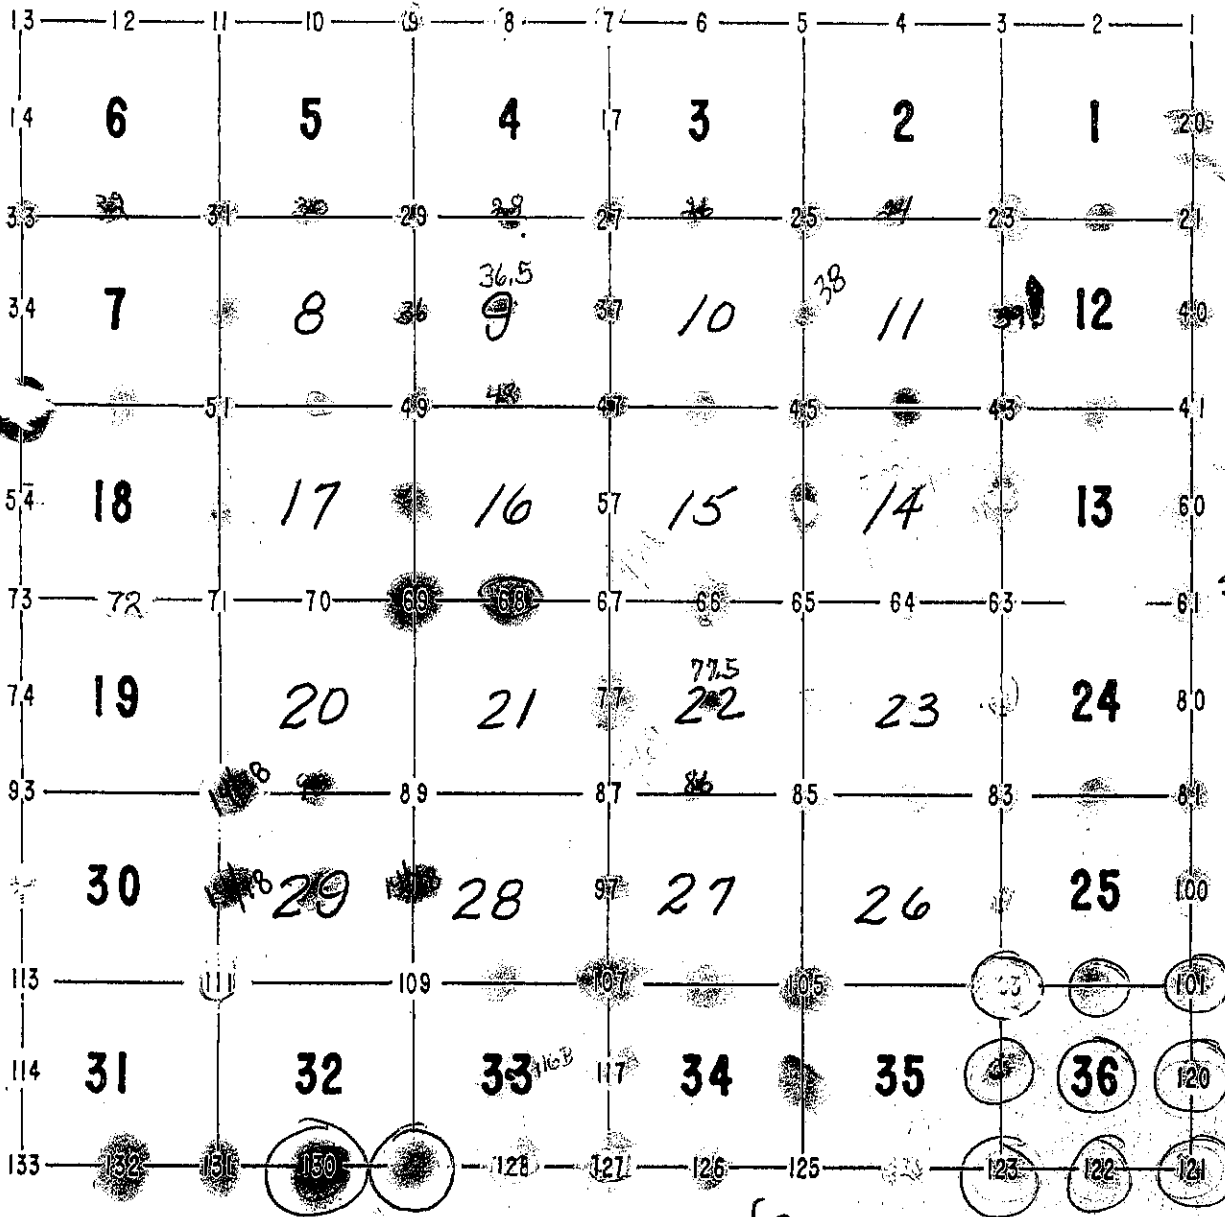

See Sec 18-8-07

53 E
NW COR
18
8 N 1 E
SW 18
8 E

73-1-06
41 10/10/04

TAX RECEIVED

N 1/4
E 1/4
336

453-00