

GRANT COUNTY CERTIFIED LAND CORNER

CORNER NUMBER 35

CERTIFICATE:


I, Larry L. Austin, do hereby certify that on the 8th day of February, 2000, I found evidence of the West 1/4 corner of Section 8, Town 8 North, Range 1 West, of the 4th Principal Meridian, and I re-established said corner according to the Wisconsin statutes as shown and described hereon.

Dated this 23rd day of June, 2000

Larry L. Austin
Larry L. Austin S-1903



SEAL

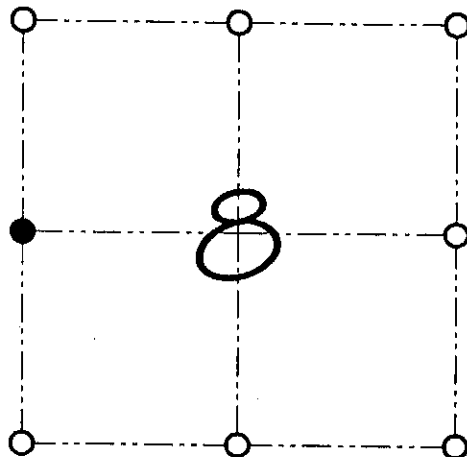

● = CORNER LOCATION
WEST 1/4 CORNER OF SECTION 8, T 8 N R 1 W TOWN OF MUSCODA

HISTORY OF ORIGINAL CORNER ESTABLISHMENT:

Corner was originally set in 1833 by Harvey Parke.
In 1989 Matthew Janiak set Number 6 iron bar at this location.

DESCRIPTION OF CORNER EVIDENCE FOUND:

I was unable to locate the Number 6 rebar. I reset the corner proportionately between the Northwest and Southwest corners for Northing. Easting was set in remains of a fence North / South.

DESCRIPTION OF CORNER AND WITNESS MONUMENTS, references and accessories used to perpetuate the original or re-established location of this corner

WITNESS TO THE CORNER LOCATION: SHANE AUSTIN & SHELBY BLINDERT & BOBBY SEDGWICK

SKETCH:

