



GRANT COUNTY

U.S. PUBLIC LAND SURVEY MONUMENT RECORD

TYPE OF MONUMENT: 3/4" X 24" Iron Rod
TIES ARE AS INDICATED ON SKETCH

WITNESSES TO CORNER LOCATION

Sean M. Walsh
 Christopher G. Reedy

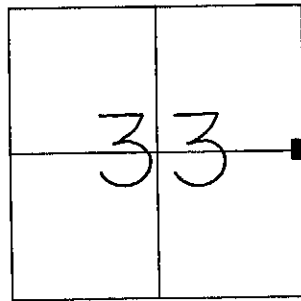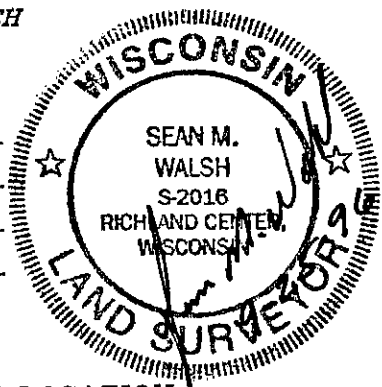

CORNER LOCATION
 East 1/4 Corner
 Section 33, T8N, R1W
 Town of Muscoda

BASIS FOR MONUMENT LOCATION

Original Gov't. survey documented two bearing trees, one of which was a 4" W. Oak N 22 W 42 lks.

1880 Joel Barber documented the same tree at a distance of 36 lks.

I located the above mentioned Oak tree which fits very well with the physical occupation in this area and monumented and perpetuated the corner shown hereon.

I re-established the corner at the distance documented by Mr. Barber in 1880 as this fits best with the occupational evidence.

I do hereby certify that the information contained hereon is true to the best of my information and belief.

■ - 3/4" X 24" Iron Rod at Corner

TIE SKETCH

Tree ties are a 60d common pole spike set in a blaze at the base of the tree as indicated.

Tie distances were measured horizontally by E.D.M.

