



GRANT COUNTY

U.S. PUBLIC LAND SURVEY MONUMENT RECORD

TYPE OF MONUMENT: 1" Iron Pipe
 TIES ARE AS INDICATED ON SKETCH

WITNESSES TO CORNER LOCATION

Sean M. Walsh
 Christopher G. Reedy

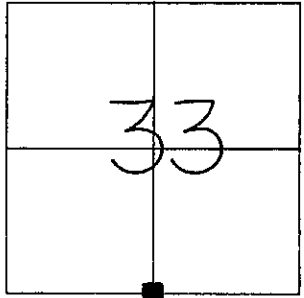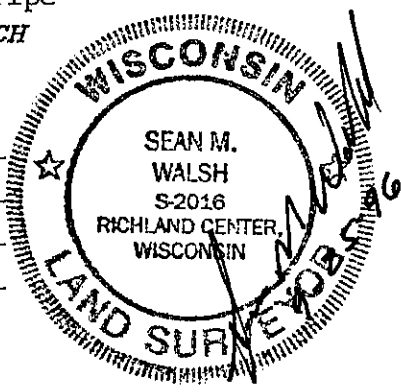

CORNER LOCATION
 South 1/4 Corner
 Section 33, T8N, R1W
 Town of Muscoda

BASIS FOR MONUMENT LOCATION

Subsequent to Original Government survey, this corner was used by Joel barber in 1880 in conjunction with a survey to subdivide the Southeast One-quarter of Section 33. I could not locate any remaining evidence of the ties which were documented by Mr. Barber.

This corner was used by Terry Cornell in February of 1993 at which time he indicated having set a 1" iron pipe.

This corner was used again in March of 1995 by Terry Cornell at which time he indicated having located a 1" Iron pipe.

I located a 1" iron pipe which fits well with the dimensions documented by Mr. Cornell.

I have accepted and perpetuated this corner in accordance with the information contained hereon and do hereby certify that this information is correct and true to the best of my knowledge and belief.

- - 1" Iron Pipe at Corner
- - 3/4" X 24" Iron Rod as Tie

