


Section Summary

14, T8N, R1W

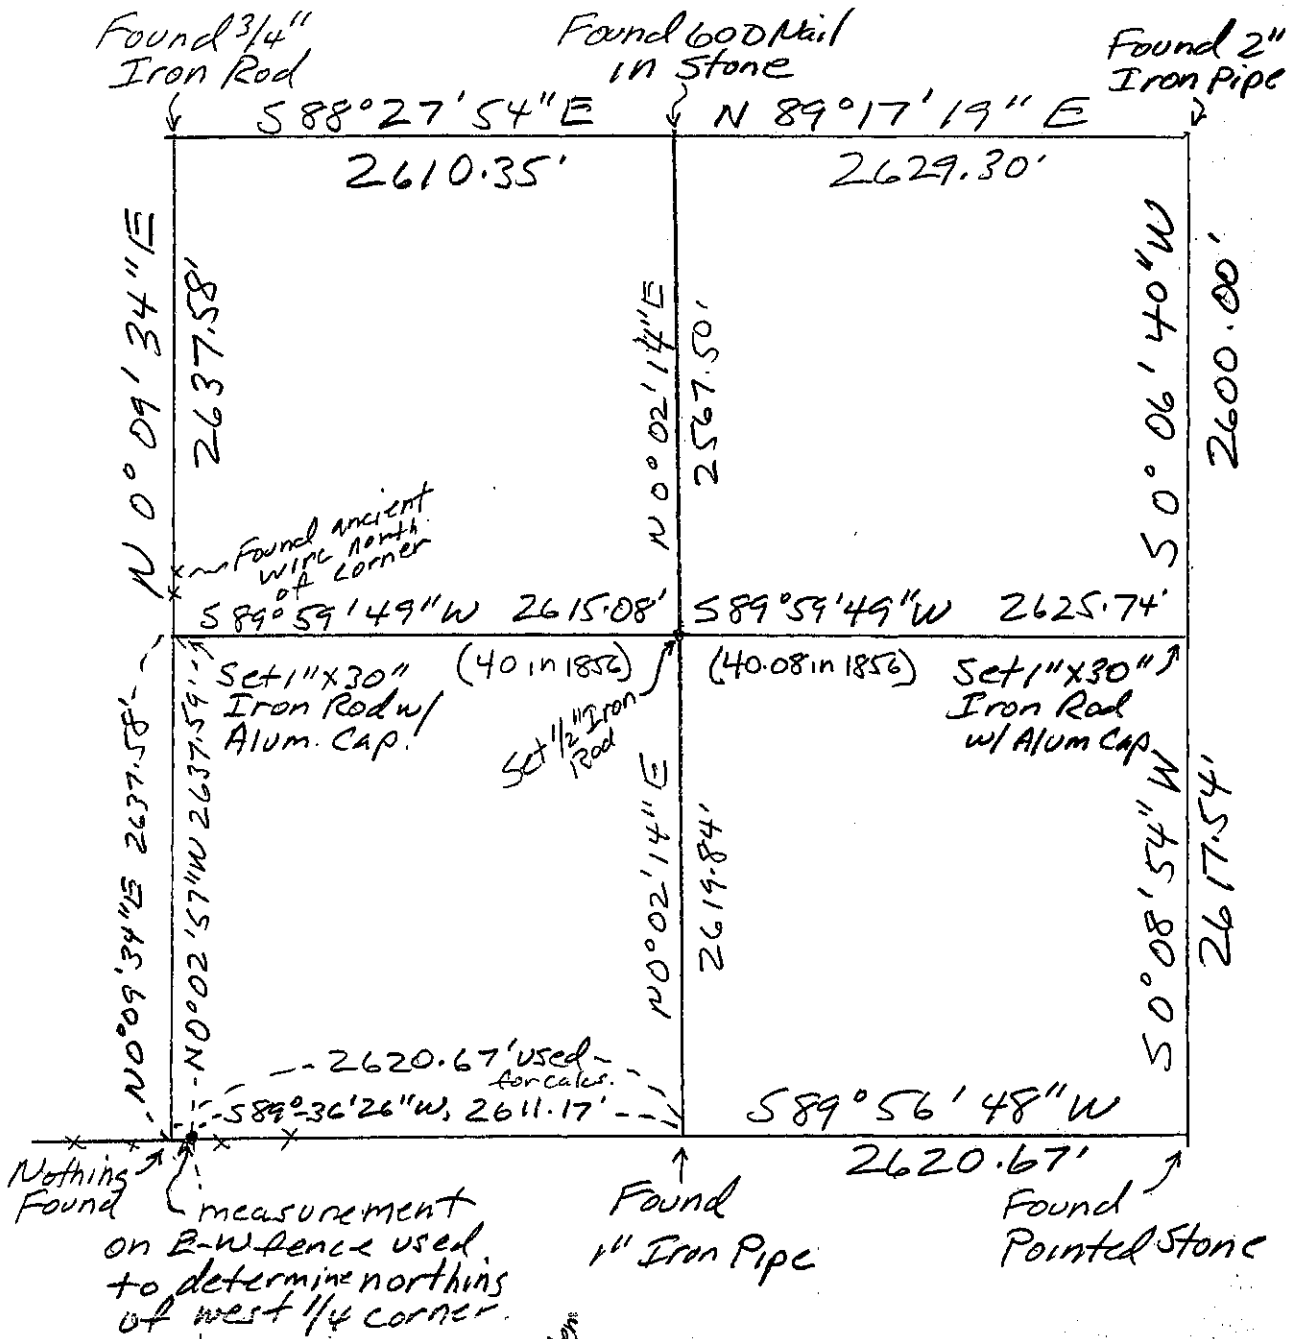

2613.67' to w/4 corner of 23, T8N, R1W

Bearings are in the Grant Co. Coord. System



Michael R. LaRosa
1/8/2002