
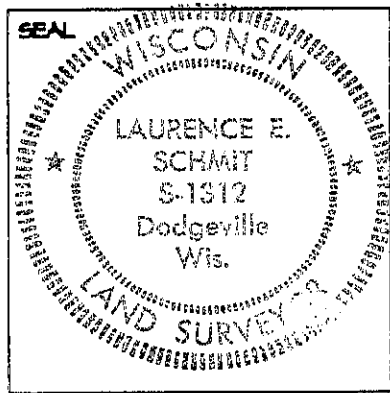


# GRANT COUNTY SECTION SUMMARY SHEET

SECTION 25 T 8 N R 18 W

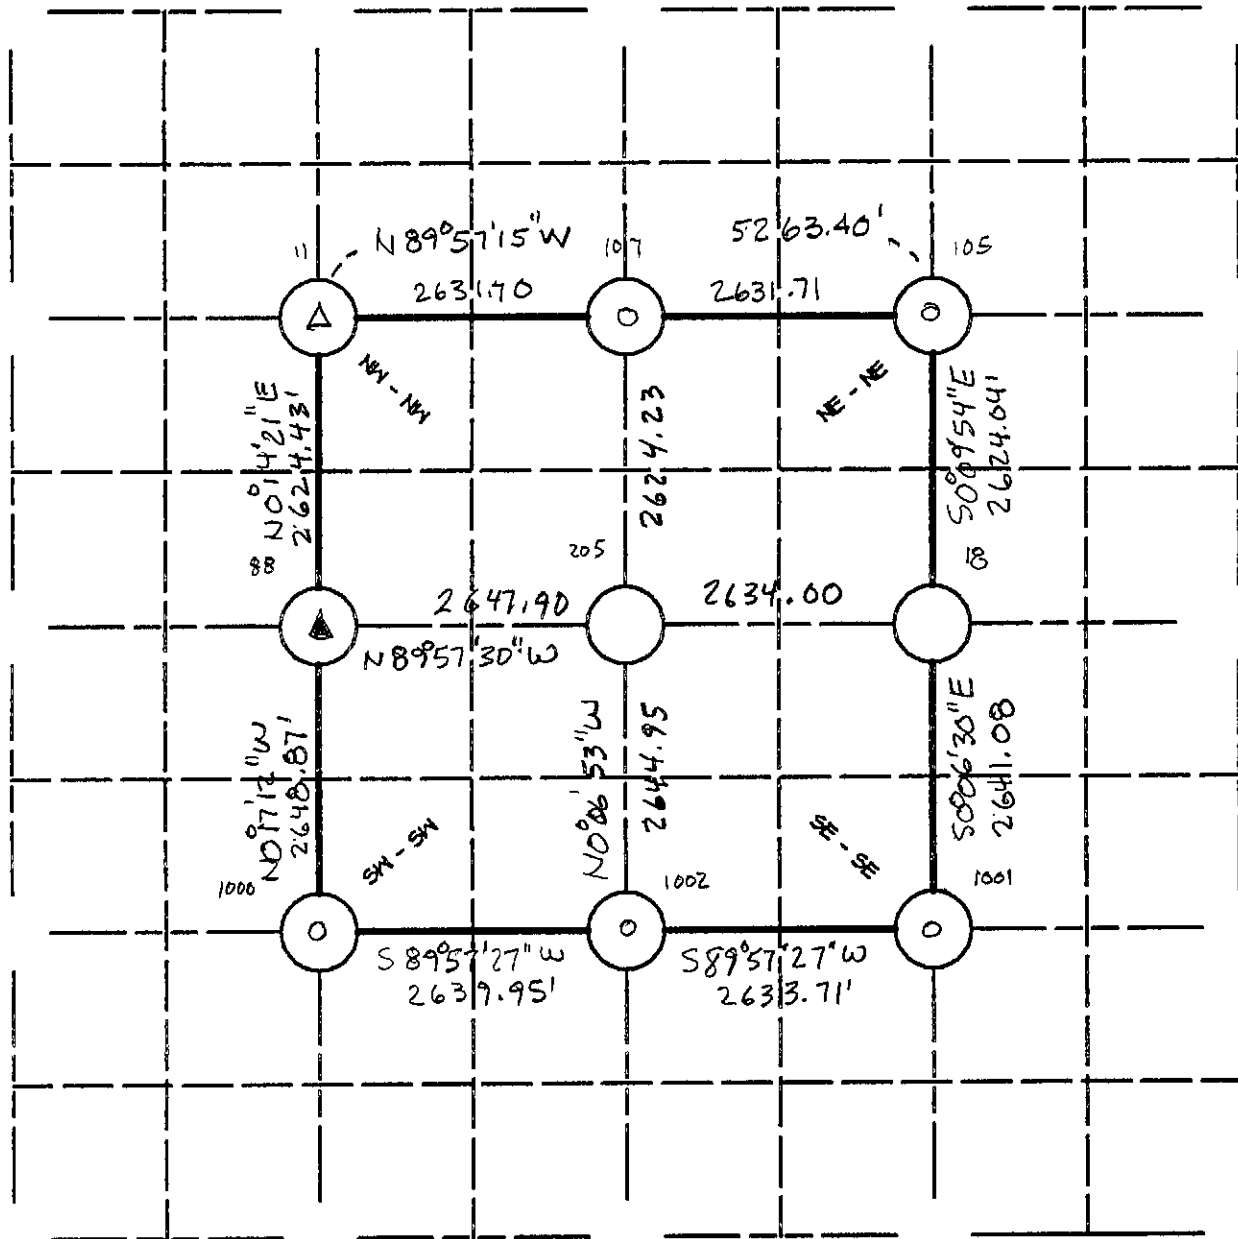

### LEGEND:

- COUNTY MONUMENT SET 7/8" x 24" REBAR WITH GRANT CO. ALUM. CAP
- △ COUNTY MONUMENT FOUND
- OTHER(Specify) \_\_\_\_\_
- ▲ OTHER(Specify) FOUND ALUM. MONUMENT
- OTHER(Specify) \_\_\_\_\_
- OTHER(Specify) \_\_\_\_\_
- OTHER(Specify) \_\_\_\_\_

JBB 095-118

Horiz. Datum <input type="checkbox"/> NAD 27 <input type="checkbox"/> NAD 83(91)	The information provided in this box is not req'd., but requested to be provided if available to the surveyor preparing this sheet; otherwise provide reference in accord with survey plat related with preparation of this sheet.
Units <input type="checkbox"/> ENGLISH <input type="checkbox"/> Metric	
Co-ordinate System <input type="checkbox"/> Geodetic <input type="checkbox"/> State Plane(S. zone) <input type="checkbox"/> GRANT County	X(easting)                      Lat Y(northing)                    Longit.

*Laurence E. Schmit* 4-4-2008  
 SIGNATURE                      DATE