


U.S. PUBLIC LAND SURVEY MONUMENT RECORD – GRANT COUNTY, WI

Summary of Section 29, Town 8 North, Range 1 West, Town of Muscodia

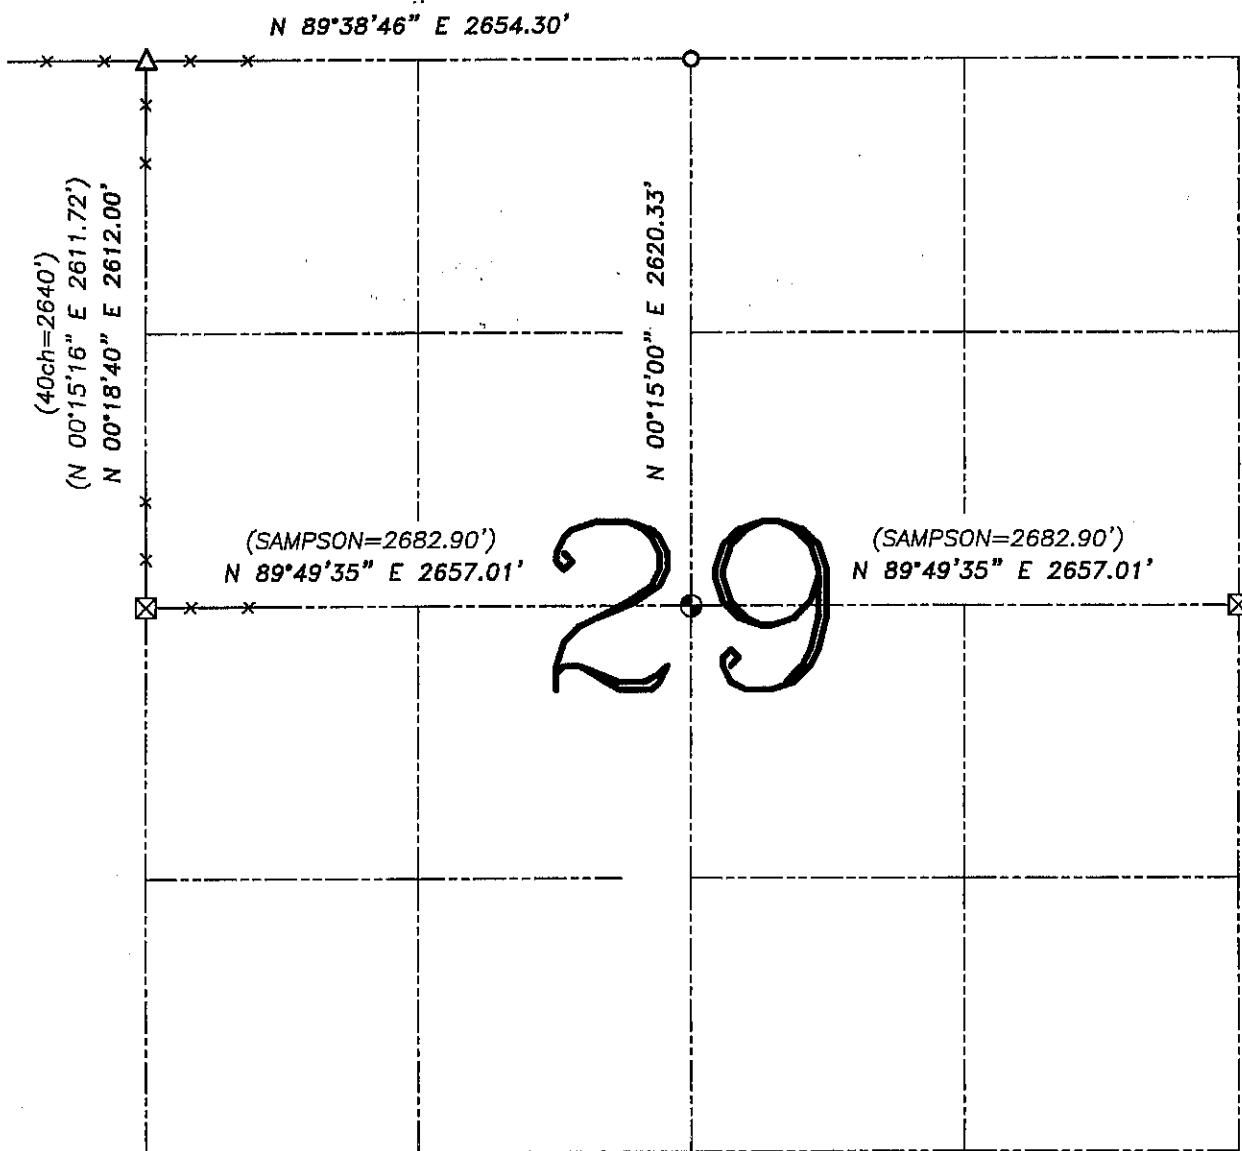

LEGEND

- ⊙ No. 8 x 30" rebar set with Grant County Aluminum Cap – wt=2.67#/l.f.
- No. 6 rebar found
- △ 1" diameter iron pipe found
- ⊠ Stone monument found
- () Recorded as
- x— Approximate location of existing fence


Relationship of all section corners to other section corners shall be shown hereon by bearing and distance or grid coordinates. Bearing reference shown below.

Dated this 10th day of June, 2004

Larry L. Austin
 Larry L. Austin S-1903

Bearings referenced to the East-West Quarter line of this Section, which is assumed to bear N 89°49'35" E.

SKETCH NOT TO SCALE

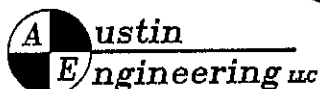

4211 HWY 81 E, LANCASTER, WI 53813
 PHONE 608-723-6363 FAX 608-723-6702

JOB NUMBER: 04S024
 FIELDBOOK: TSDR, 2332
 G:\T8NR1W\29
 H:\TIE\T8NR1W\29SUM

DRAWN BY: SW AUSTIN
 APPROVED: LL AUSTIN