


SECTION CORNER TIE SHEET INDEX

T. 8-9 N., R. 2 W

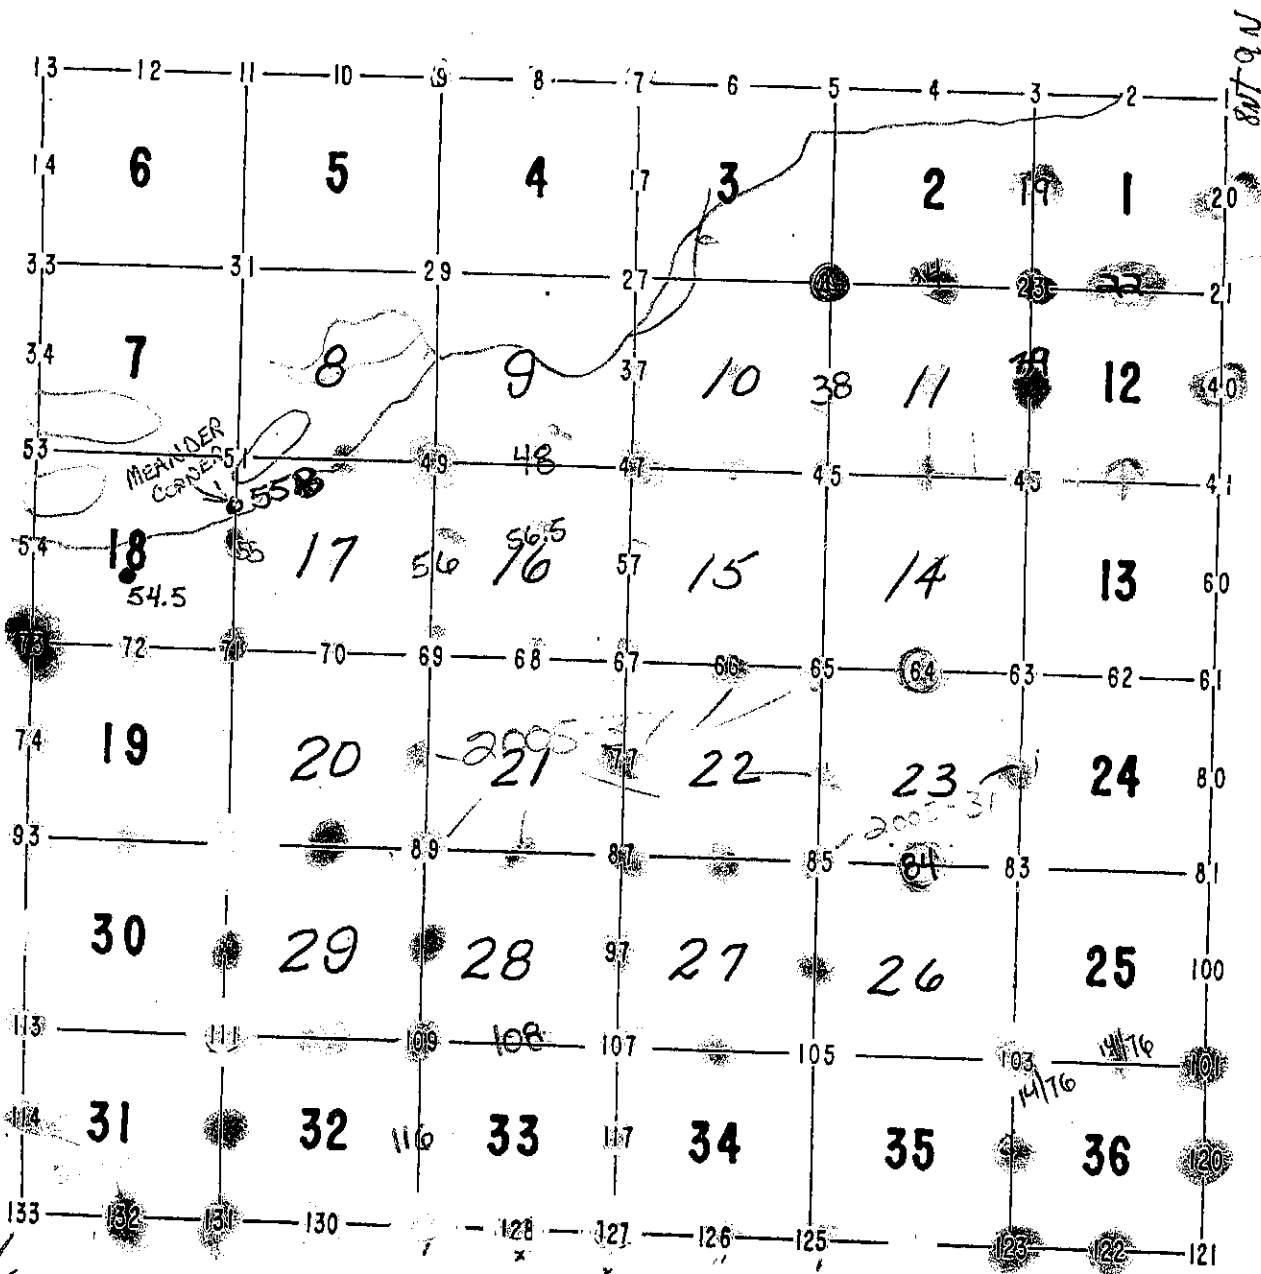

SEE 7-3

56-1-06

38/10/20
43-1-10