

82021

U.S. PUBLIC LAND SURVEY MONUMENT RECORD - GRANT COUNTY, WI

Section 12, Town 8 North Range 2 West, Town of Watterstown (a)

NOTE: This form is intended and designed to fulfill all requirements of the Wisconsin Administrative Code Chapter A-E 7.08, U.S. Public Land Survey Monument Record (3) (a) (b) (c) (d) (e) (f) (g) (h) (i).


CERTIFICATE: (i)

I, Aaron J. Austin, Wisconsin Professional Land Surveyor, do hereby certify that the corner location on this record was determined by me and/or under my direct supervision and that this U.S. Public Land Survey Monument Record is correct and complete to the best of my knowledge and belief.

Dated this 29th day of April, 2022.

Aaron J. Austin

Aaron J. Austin, S-2922

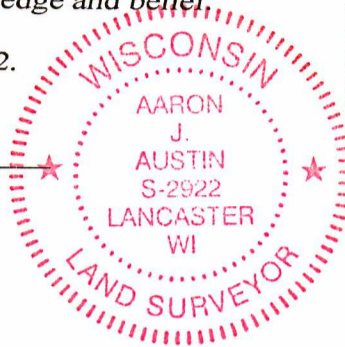

⊕ = CORNER LOCATION

Grant County Coordinates:
NAD 83 (2011)
Northing: 648,775.60
Easting: 862,413.06

HISTORY OF CORNER ESTABLISHMENT:

Original corner was set in 1833 by Silvester Sibley.
Kenneth Kerst set an Aluminum Monument on a Survey filed in Book G, Page 48 dated 4/10/1980.
Paul Chafer found a 1 1/4" Iron pipe and prepared a Survey Monument Record filed 8/29/1986.

DESCRIPTION OF CORNER EVIDENCE FOUND: (b) (f) (g) (h)

I found an 1 1/4" Iron Pipe Chafer referenced. I set four witness corners after I verified the Monument's location with G.P.S. and E.D.M. methods.

DESCRIPTION OF CORNER AND WITNESS MONUMENTS, references and accessories used to perpetuate the original or re-established location of this corner. (c) (d) (e)


Witnesses to corner location Shane Austin.
Drawn by Owen Austin

SKETCH:

LEGEND

- ⊕ Section Corner—as designated
- 5/8" x 18" rebar set
- x-x-x- Existing fence

W O O D S

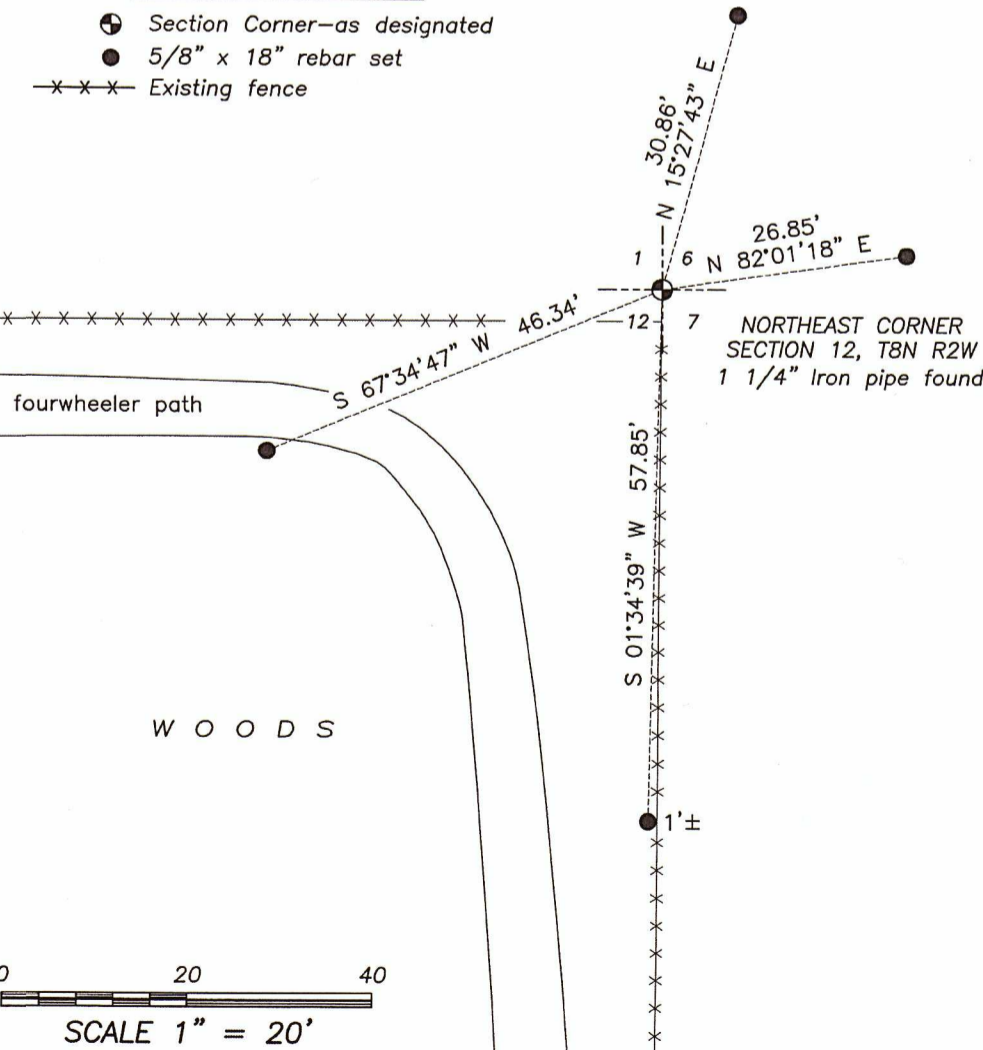

W O O D S

