


REC'D FEB 10 1997

Survey Monument Record

CORNER NO. \_\_\_\_\_  
SECTION 11  
TOWN 8N  
RANGE 2W

TYPE OF MONUMENT 1" IRON PIPE  
STATE PLANE COORDINATES: N \_\_\_\_\_  
E \_\_\_\_\_  
ELEVATION — M.S.L. DATUM: \_\_\_\_\_  
THETA ANGLE: \_\_\_\_\_  
FIELD BOOK: \_\_\_\_\_  
PAGE \_\_\_\_\_

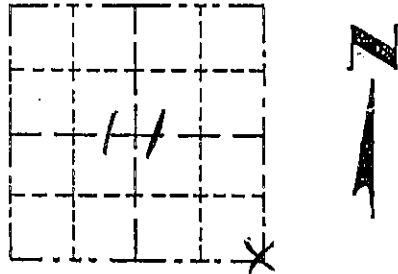

LOCATION  
(Indicated by "X")

- FOUND PERPETUATED LOCATION
- OBLITERATED EVIDENCE LOCATION
- LOST CORNER (RESTORED BY PROPORTIONATE METHODS)

BASIS FOR MONUMENT LOCATION

(Use reverse side if necessary)

Show info such as: History of corner, with reference to Vol. and pg., dates, surveyor; exact description of monument replaced; if location computed, by taped or EDM traverse; landowner, remarks, etc.

The corner location was restored based on testimonial evidence of area residents who remembered the corner being removed a generation ago. Wires of the old line fence to the west were still to be found in trees as well as a set post on the west side of the road approximately 130' west of the corner. The line to the south is still in place. These lines were projected and intersected. The corner fell approximately 3 1/2' north of a recently constructed fence. It fits the 2 corners to the north nearly perfect.

CERTIFIED CORRECT TO THE BEST OF MY KNOWLEDGE AND BELIEF

Michael R. LaRosa  
Registered Land Surveyor

DATE: 1/14/1997

TIE SKETCH

Show at least (4) ties and monuments

