

Survey Monument Record

CORNER NO. _____ SEP 22 1994
 SECTION 23
 TOWN 8N
 RANGE 2W

TYPE OF MONUMENT 1/4" Iron Pipe w/ Grant Co. Cap.


STATE PLANE COORDINATES: N _____
 E _____

ELEVATION — M.S.L. DATUM: _____

THETA ANGLE: _____

FIELD BOOK: 92-5

PAGE 29

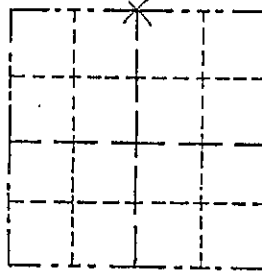

LOCATION
 (Indicated by "X")

BASIS FOR MONUMENT LOCATION

(Use reverse side if necessary)

Show info such as: History of corner, with reference to Vol. and pg., dates, surveyor; exact description of monument replaced; if location computed, by taped or EDM traverse; landowner, remarks, etc.

SEAL:

Monument was placed at the existing occupied corner (3 way fence intersection) after an E.D.M. traverse of the area. Testimonial evidence of "old" area farmers indicate that a dead 30" oak just south of the corner has been dead for at least 30 years. There are several ancient types of barbed wire wrapped around and through this tree possibly sparing it from the loggers. It is believed to be one of the original bearing trees as called for in the govt. notes.

CERTIFIED CORRECT
Laurence E. Schmit

Registered Land Surveyor

DATE: 10/23/92

TIE SKETCH

Show at least three (4) ties and monument

