


REC'D AUG 19 1997

GRANT COUNTY U.S. PUBLIC LAND SURVEY MONUMENT RECORD

TYPE OF MONUMENT: 3/4" X 24" IRON ROD PLACED
TIES ARE AS INDICATED ON SKETCH

WITNESSES TO CORNER LOCATION
Reginald Jaquish
Chris Ruetten

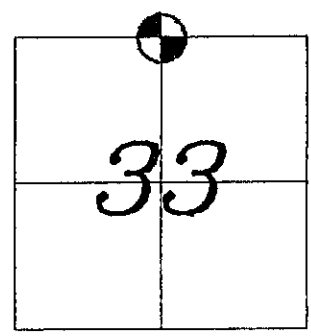


CORNER LOCATION
N 1/4 CORNER 33, T89, R2W

BASIS FOR MONUMENT LOCATION

I could not find any evidence of any previous survey at this location, therefore I re-established this corner at this location of physical occupation and monumented and perpetuated as shown hereon.

This information is correct and true to the best of my information, knowledge and belief.

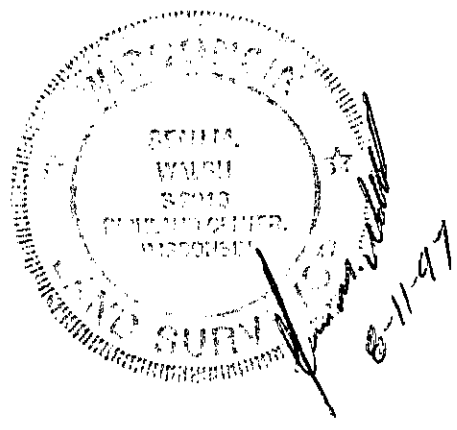

TIE SKETCH

