

# U. S. PUBLIC LAND SURVEY MONUMENT TIE SHEET - GRANT COUNTY WISCONSIN.



Section # 31, Town 8 North, Range 2 West, Town of  
Watterstown.

**Certificate**

I, Craig E Hardy, do hereby certify that the corner location on this record was determined by me and/or under my direct supervision and that this U.S. public land survey monument record is correct and complete to the best of my knowledge and belief.

Dated this 21st day of March, 2007.

*Craig E Hardy*  
Craig E Hardy, WI-RCS #2304

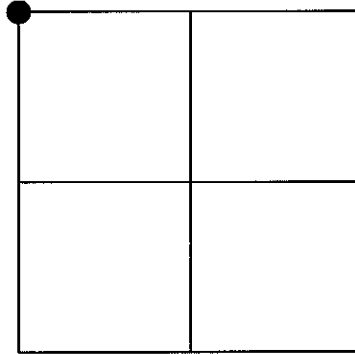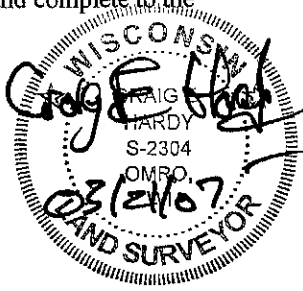

**History of Corner Establishment**

The original corner was set in 1833. I found a stone pile and 24" Dia. depression just north thereof. Could find no evidence or remains of a called for post at this location. No other record or evidence exists.

**Description of Corner Evidence Found:**

Both of the adjacent owners to this corner (Charlie Baumeister and Irene McNamee) admitted the current fences aren't accurate within the Boscobel township at this location. I re-established the corner location by acceptance of the found stone pile and sink hole for distance and direction. A GPS and EDM traverse of the area, and occupation of fences at the center of sections supports this location.

**Description of Corner and Witness Monuments, references and accessories used to perpetuate the original or re-established location of this corner.**

Witnesses to corner location \_\_\_\_\_

**SKETCH:**

**Legend**

- Set 1" dia. x 30" iron rebar w/ alum. cap
- Set 1/2" dia. x 24" iron rebar

