

U. S. PUBLIC LAND SURVEY MONUMENT TIE SHEET - GRANT COUNTY WISCONSIN.



Section # 31 , Town 8 North, Range 2 West, Town of
Watterstown.

Certificate

I, Craig E Hardy, do hereby certify that the corner location on this record was determined by me and/or under my direct supervision and that this U.S. public land survey monument record is correct and complete to the best of my knowledge and belief.

Dated this 21st day of March, 2007.

Craig E Hardy
Craig E Hardy, WI-RLS #2304

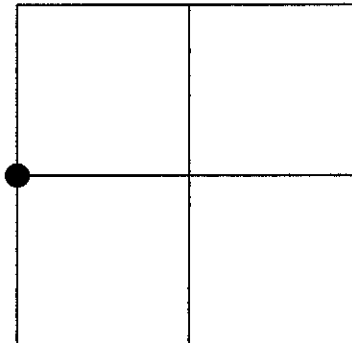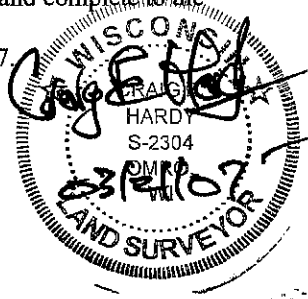

History of Corner Establishment

The original corner was set in 1833.

Description of Corner Evidence Found:

I found a disturbed stone monument laying on the ground in the vicinity of the stump. No other evidence of the original corners were found. Accepted the stump for direction based on fence lines of occupation attached thereto. After an extensive GPS and EDM survey of other fences in the section, I re-established this corner by fitting occupation of the fences.

Description of Corner and Witness Monuments, references and accessories used to perpetuate the original or re-established location of this corner.

Witnesses to corner location _____

SKETCH:

