


REC'D AUG 19 1997

# GRANT COUNTY U.S. PUBLIC LAND SURVEY MONUMENT RECORD

TYPE OF MONUMENT: 3/4" x 24" Iron Rod set  
TIES ARE AS INDICATED ON SKETCH

WITNESSES TO CORNER LOCATION

Reginald Jaquish  
Christopher Ruetten

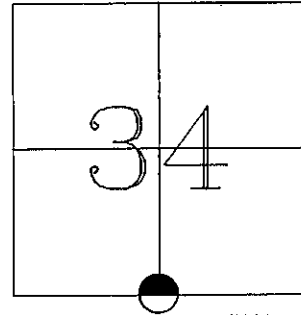

CORNER LOCATION

SOUTH 1/4 SECTION 34, T8N, R2W

### BASIS FOR MONUMENT LOCATION

Subsequent to Original Gov't. Survey of 1832, I could no locate any record evidence of this corner having been used.

I located the remains of a Tree which I believe to be one used in the original Gov't. Survey. I re-established this corner according to said tree and set a 3/4" x 24" iron rod and perpetuated according to the information contained hereon.

I do hereby certify that this information is correct and true to the best of my knowledge and belief.

### TIE SKETCH

