


REC'D AUG 19 1997

GRANT COUNTY U.S. PUBLIC LAND SURVEY MONUMENT RECORD

TYPE OF MONUMENT: 3/4" Rebar
TIES ARE AS INDICATED ON SKETCH

WITNESSES TO CORNER LOCATION

Reginald Jaquish
Christopher Ruetten

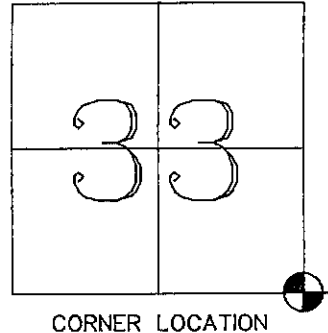


CORNER LOCATION

BASIS FOR MONUMENT LOCATION

SE Cor. S33, T8N, R2W

I re-established this corner at a location which is on a projection of occupied lines. This location is well within reasonable proximity of a proportionate locaion. I monumented and perpetuated this corner as shown hereon.

I do hereby certify that this corner is correct and true to the best of my information, knowledge and belief.

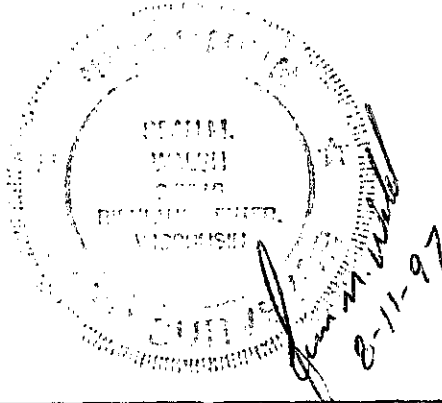

TIE SKETCH

