


REC'D AUG 19 1997

GRANT COUNTY U.S. PUBLIC LAND SURVEY MONUMENT RECORD

TYPE OF MONUMENT: 3/4" REBAR
TIES ARE AS INDICATED ON SKETCH

WITNESSES TO CORNER LOCATION

Reginald Jaquish
Christopher Ruetten

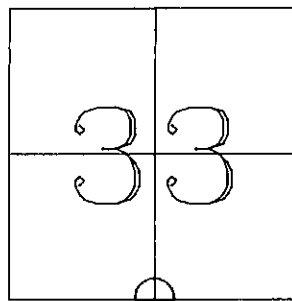

CORNER LOCATION

BASIS FOR MONUMENT LOCATION

S 1/4 Cor. Sec 33, T8N, R2W

I could not find any evidence of any previous survey, therefore I Accepted this location as physical occupation as the only acceptable evidence and monumented and perpetuated as shown hereon.

I do hereby certify that the information contained hereon is correct and true to the best of my information, knowledge and belief.

[Handwritten signature]
8-11-97

TIE SKETCH

