


U.S. PUBLIC LAND SURVEY MONUMENT RECORD – GRANT COUNTY, WI

Summary of Section 21, Town 8 North, Range 2 West, Town of Watterstown

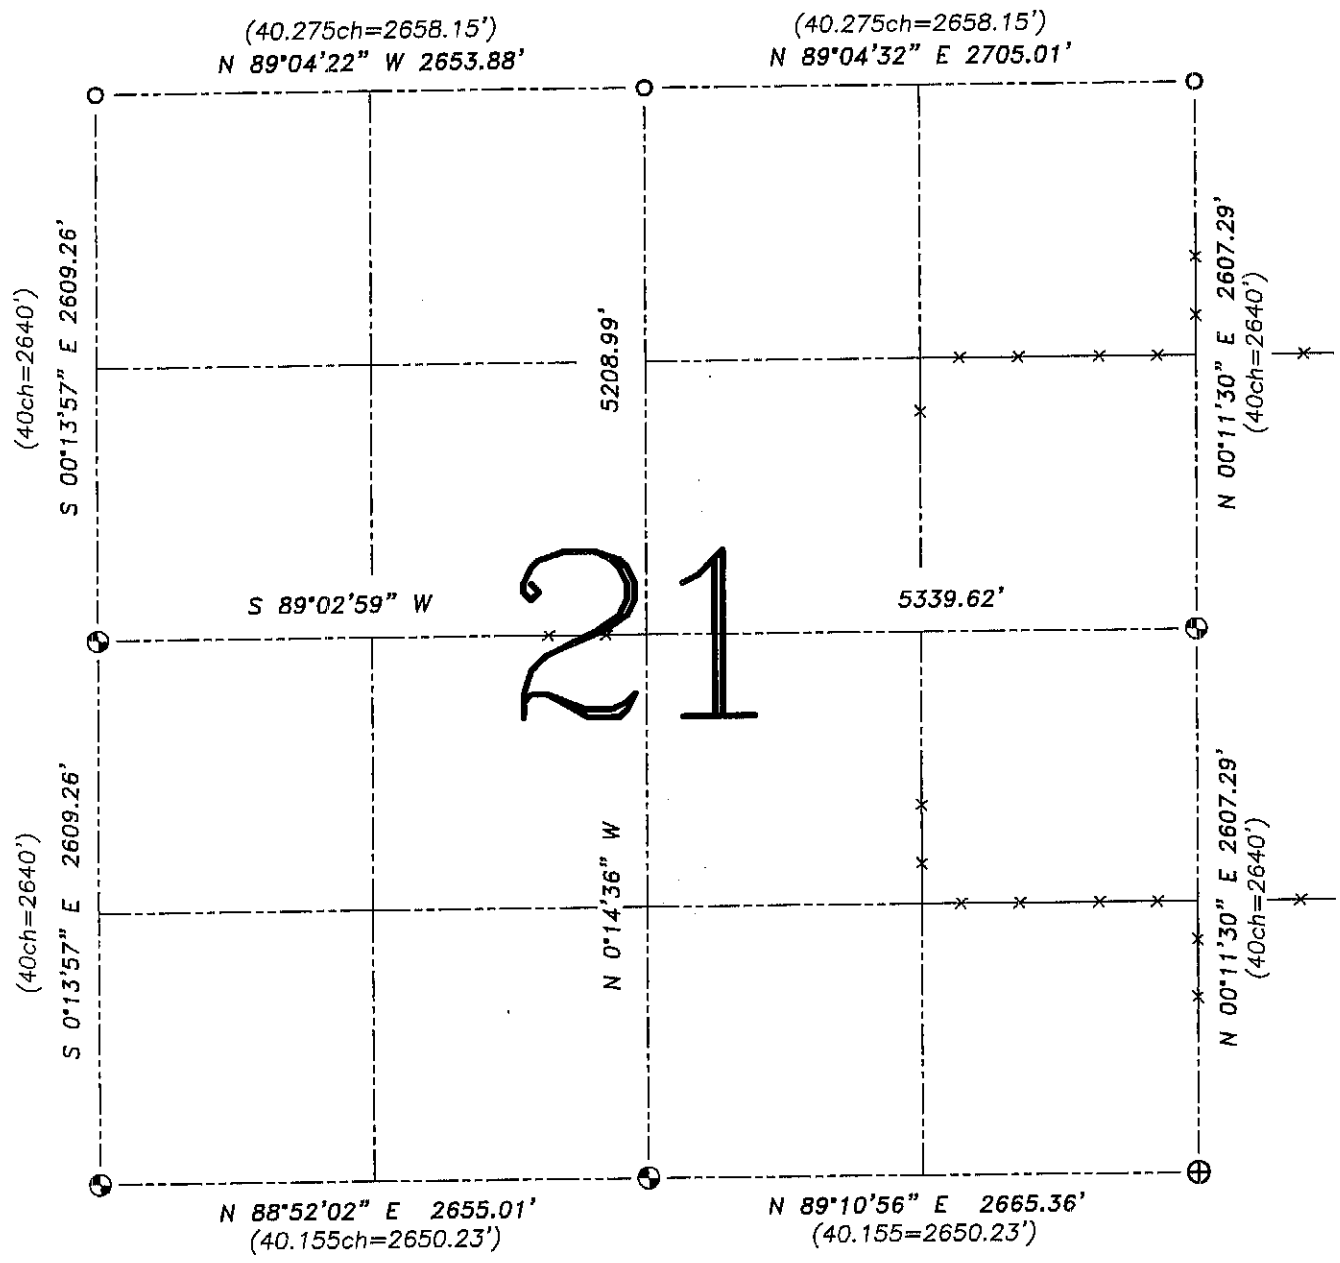

LEGEND

- ⊙ No. 8 x 30" rebar set with Grant County Aluminum Cap – wt=2.67#/l.f.
- ⊕ No. 8 rebar found with Grant County Aluminum Cap
- No. 6 rebar found

() Recorded as


—x— Approximate location of existing fence



Relationship of all section corners to other section corners shall be shown hereon by bearing and distance or grid coordinates. Bearing reference shown below.


Dated this 25th day of November, 2005

Larry L. Austin
Larry L. Austin S-1903

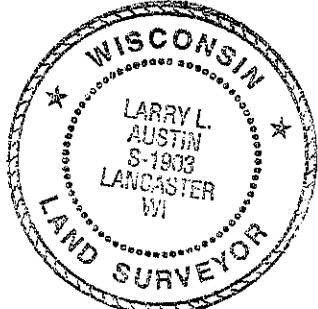

Bearings referenced to the South line of the Southwest Quarter of Section 21, which is assumed to bear N $88^{\circ}52'02''$ E

SKETCH NOT TO SCALE

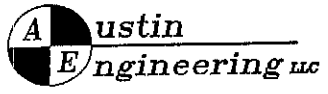

4211 HWY 81 E, LANCASTER, WI 53813
PHONE 608-723-6363 FAX 608-723-6702

JOB NUMBER: 04S149
FIELDBOOK: 2505
G:\T8NR2W\27
H:\TIE\T8NR2W\21SUM

DRAWN BY: *sw* AUSTIN
APPROVED: LL AUSTIN