

GRANT COUNTY

REC'D MAY 7 1996

Survey Monument Record

TYPE OF MONUMENT 1" IRON PIPE FND

STATE PLANE COORDINATES: N _____
E _____

ELEVATION — M.S.L. DATUM: _____

THETA ANGLE: _____

FIELD BOOK: 95-15


PAGE _____

CORNER NO. 124

SECTION 35

TOWN 8N

RANGE 3W

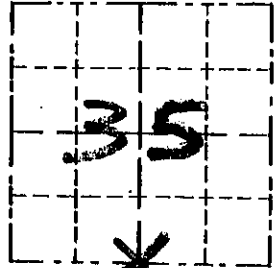

LOCATION
(Indicated by "X")


BASIS FOR MONUMENT LOCATION

(Use reverse side if necessary)

FOUND 1" IRON PIPE AND ACCEPTED IT AFTER VERIFICATION BY EDM TRAVERSE OF THE AREA. THE PIPE WAS SHOWN ON A 1987 CSM (C.S.M. #267) BY MARKS

CORNER WAS ORIGINALLY SET IN 1832 BY SIBLEY.

SEAL:

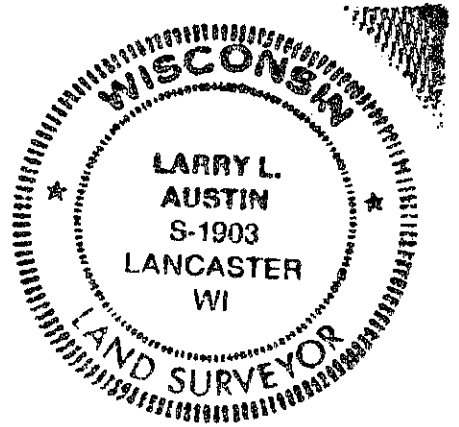


CERTIFIED CORRECT

Larry L. Austin
Registered Land Surveyor

DATE: 2/16/96

TIE SKETCH

Show at least three (3) ties and monument

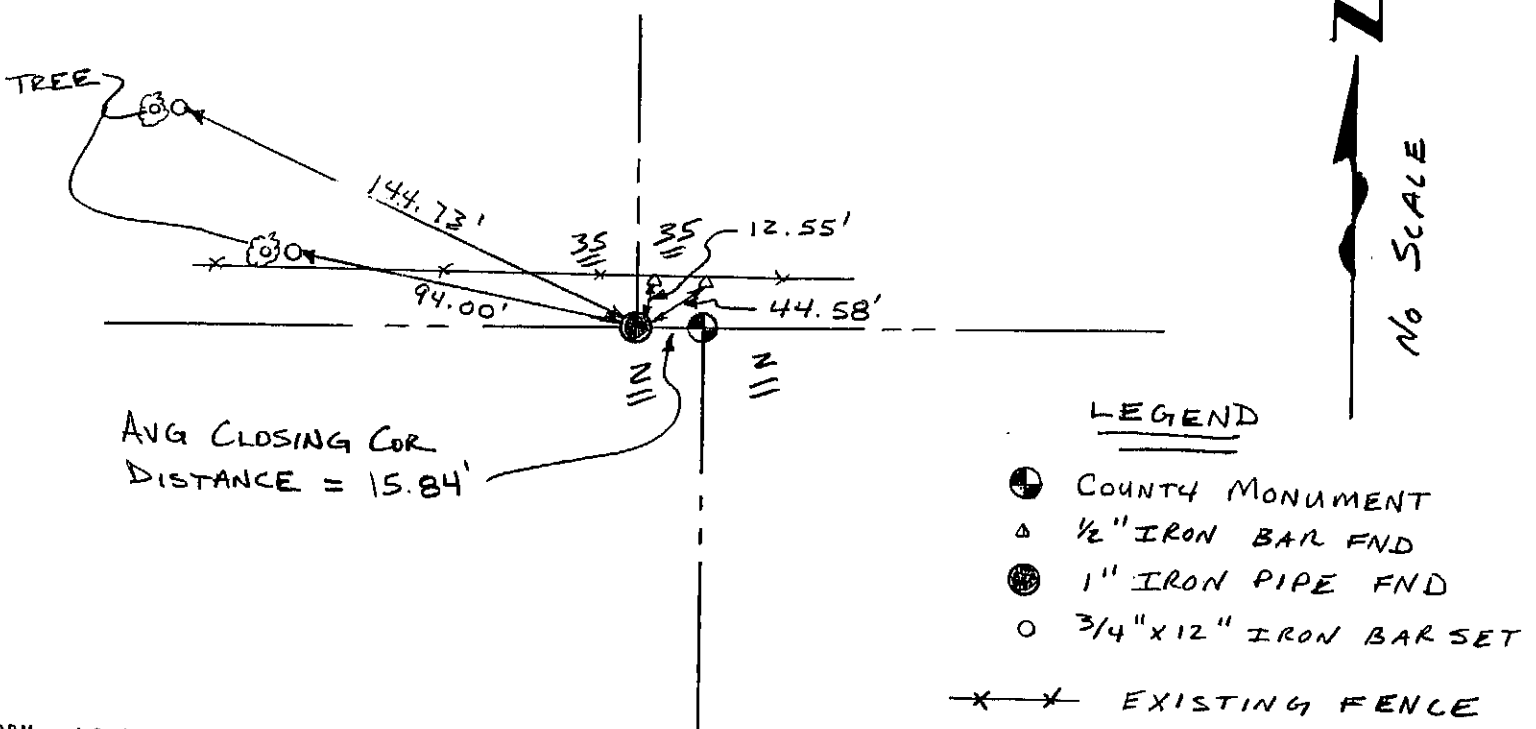

AVG CLOSING COR
DISTANCE = 15.84'

LEGEND

- COUNTY MONUMENT
- △ 1/2" IRON BAR FND
- 1" IRON PIPE FND
- 3/4" x 12" IRON BAR SET
- X — X — EXISTING FENCE