


# U.S. PUBLIC LAND SURVEY MONUMENT RECORD

Section 7, Town 1 North Range 1 West, Town of Hazel Green, Grant County, Wisconsin

## CERTIFICATE

I, Larry L. Austin, do hereby certify that the corner location on this record was determined by me and/or under my direct supervision and that this U.S. public land survey monument record is correct and complete to the best of my knowledge and belief.

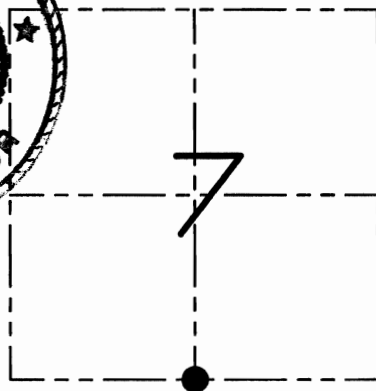

● = CORNER LOCATION

*Larry L. Austin* 6/8/09  
 Larry L. Austin, S-1903 date

## HISTORY OF CORNER


Corner was originally set in the 2nd quarter of 1832 by Lyon. In 1847 Stuntz tied to the corner. In 1858 Hayden tied to the corner. In 1879 Barber tied to the corner. In 1976 Krohn tied to the corner. No other recent record of the corner was found.

## CORNER EVIDENCE FOUND

I found an occupied location at the corner. No evidence of previous monuments was found. I accepted the occupied location after an EDM & GPS traverse of the area.

**DESCRIPTION OF CORNER AND WITNESS MONUMENTS**, references and accessories used to perpetuate the original or re-established location of this corner. Witnesses to monument location Bobby Sedgwick & Brad Digman & Shane Austin

## SKETCH:

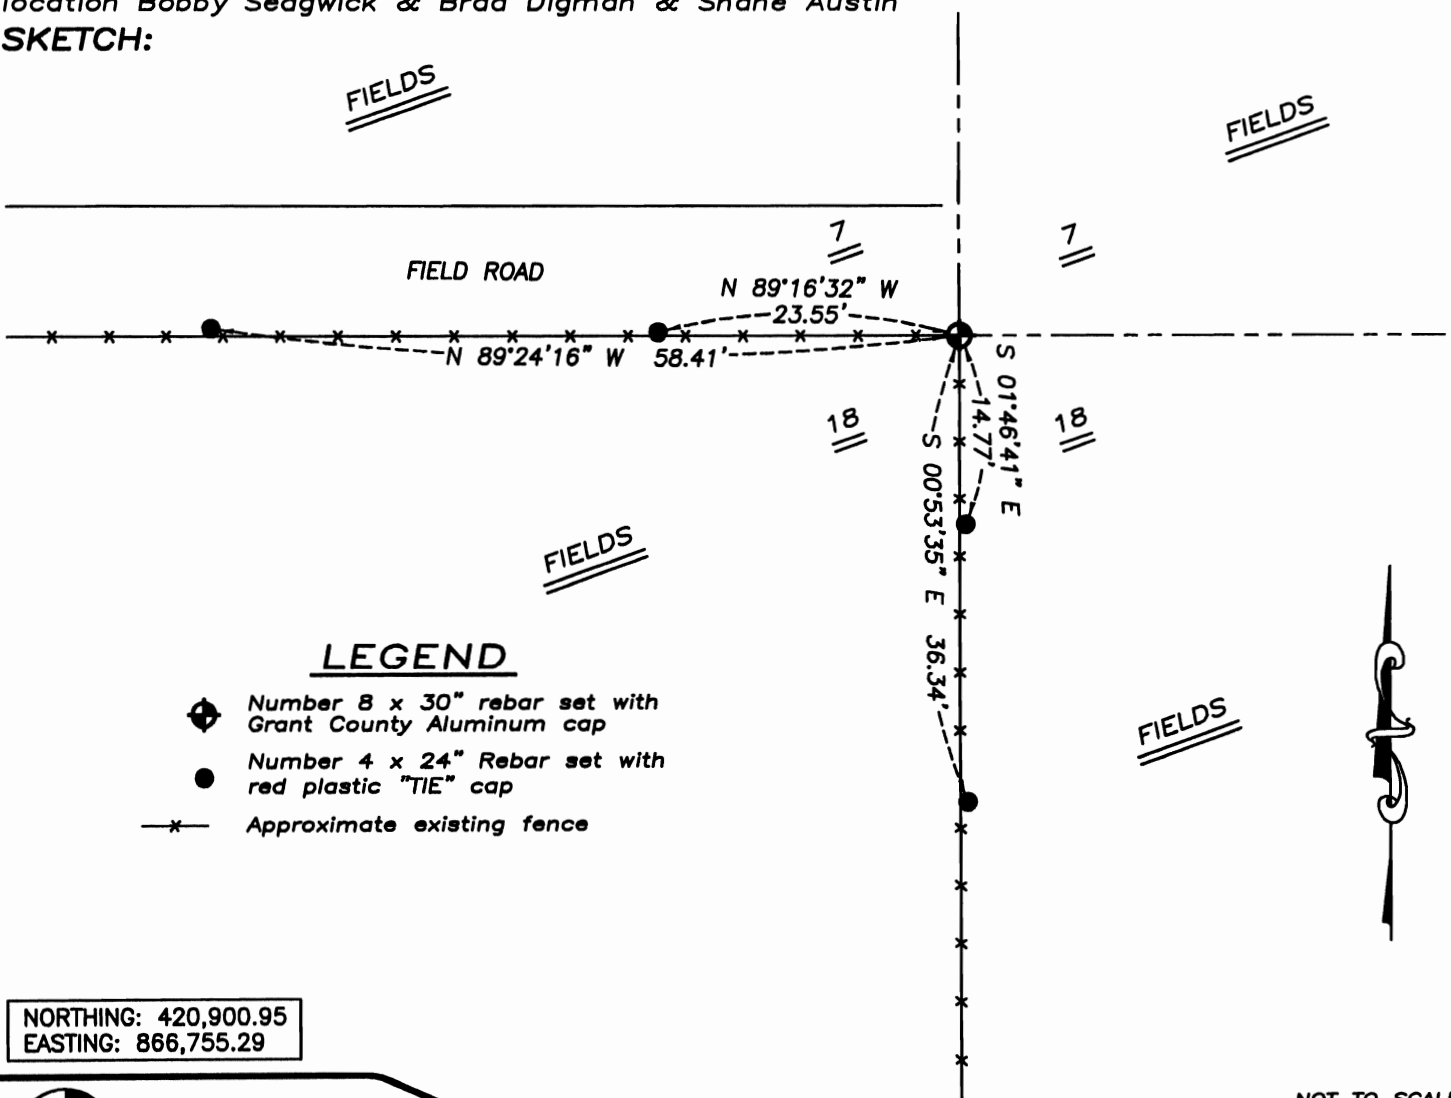

## LEGEND

- ⊕ Number 8 x 30" rebar set with Grant County Aluminum cap
- Number 4 x 24" Rebar set with red plastic "TIE" cap
- x- Approximate existing fence

NORTHING: 420,900.95  
 EASTING: 866,755.29

NOT TO SCALE

**Austin Engineering LLC**

4211 HWY 81 E, LANCASTER, WI 53813  
 PHONE 608-723-6363 FAX 608-723-6702

JOB NUMBER 08S002  
 FIELDBOOK: TDSR, 2910  
 G:\T1NR1W\T1NR1W  
 H:\TIE\T1NR1W\52

DRAWN BY: SW AUSTIN  
 APPROVED: LL AUSTIN