

U. S. PUBLIC LAND SURVEY MONUMENT RECORD

COUNTY


INSTRUCTIONS:

This record shall show the location of the corner and shall include all of the following nine elements (a through i).

(a) Identify the corner by reference to the U.S. public land survey system.

O = Corner monument restored.

Corner Restored was the NW Corner of Section 15, Township 1 North, Range 1 West.

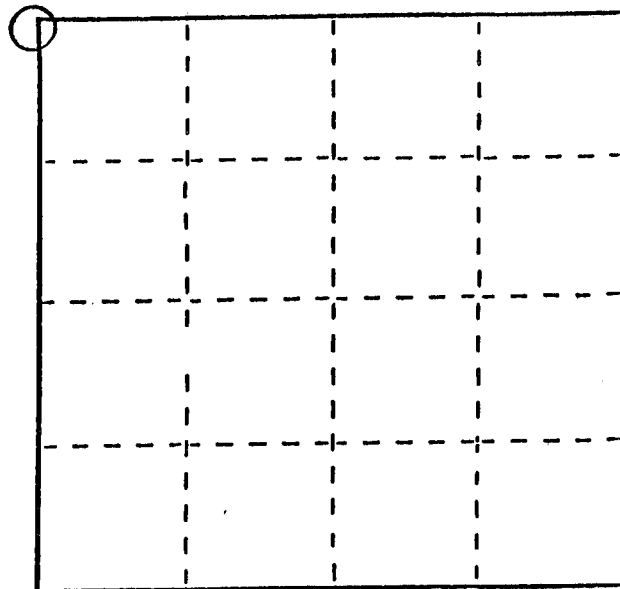

SECTION 15, T. 1 N. R. 1 W
TOWN OF HAZE GREEN

(b) Describe any record evidence, monument evidence, occupational evidence, testimonial evidence or any other material evidence you considered, and whether the monument was found or placed.


Record Survey in part of Section 15, dated June 28th, 1859 by County Surveyor. Did not find any evidence of corner. Accepted centerline of existing paved roadway and fence line extension from west after EDM traverse of the area. Placed 3/4" x 24" rebar @ roadway surface.

(c) In the plan view drawing below, provide reference ties to at least 4 witness monuments, or, if the location is within a municipality, to at least 2 witness monuments. (Witness monuments shall be made of concrete, natural stone, iron or other equally durable material.) Describe witness monuments.

(d) Show a plan view drawing depicting the relevant monuments and reference ties which is sufficient in detail to enable accurate relocation of the corner monument if the corner monument is disturbed. Indicate north.

TIES TO MON.

- 1- 0°00'00"; 29.69
- 2- 291°21'40"; 30.12
- 3- 164°56'40"; 30.71
- 4- 87°43'36"; 55.10

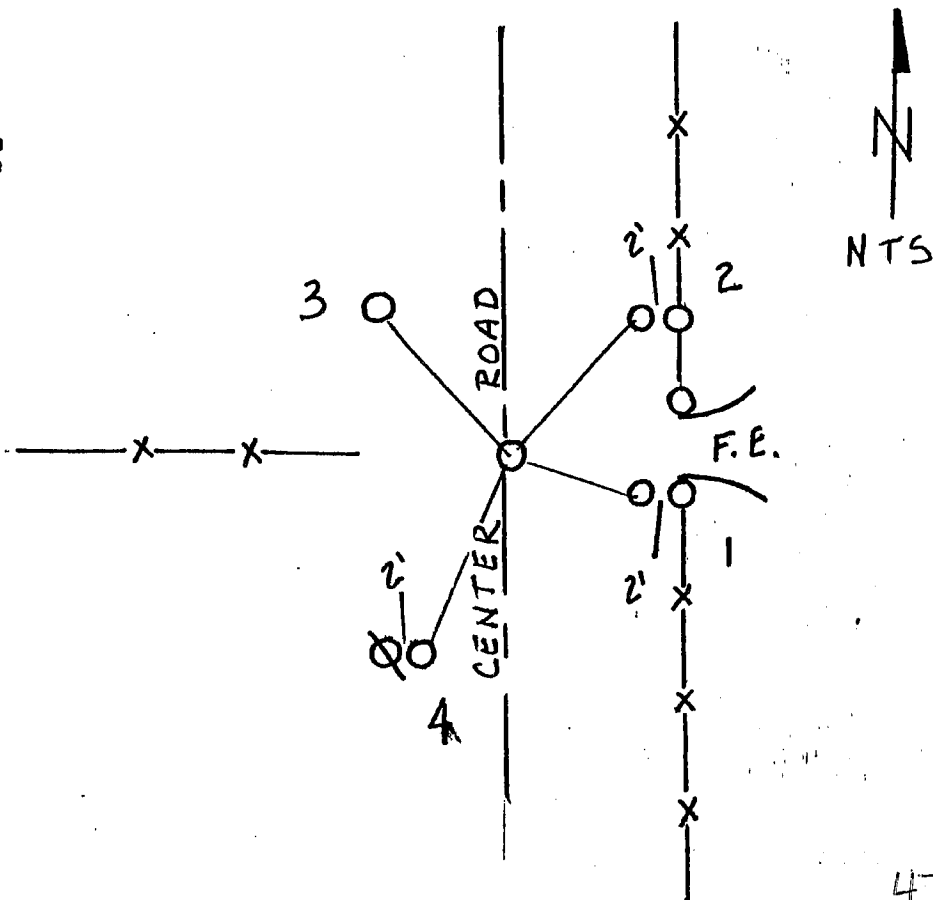

(e) Describe any material discrepancy between the location of the corner as restored or reestablished and the location of that corner as previously restored or reestablished by distance and direction. Show the discrepancy on the plan view drawing under (d), above. Show the distances between the corner as previously restored or reestablished and (1) the corner as restored or reestablished, and (2) to at least 2 of the witness monuments shown on the drawing in (d), above.

NA


(f) Was the corner restored through acceptance of (1) an obliterated evidence location, or, (2) a found perpetuated location?

(g&h) Was the corner reestablished through lost corner proportionate methods? If so, show the method, including the directions and distances to other public land survey corners used as evidence or used for proportioning in determining the corner location?

NO

(1) I, RODERICK D STEEGE
(type or print name) certify that the corner location shown on this record was determined by me or under my direction and control and that this U.S. Public Land Survey Monument Record is correct and complete to the best of my knowledge and belief.

[Signature]
Signature Date 7/16/96

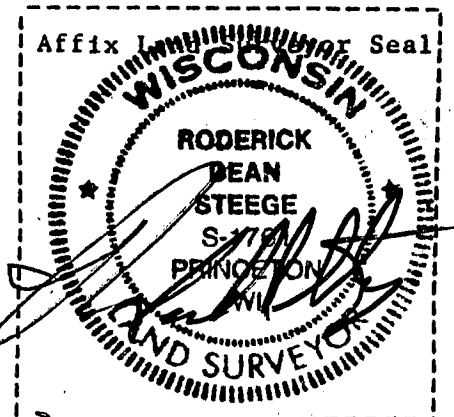

Rust et I
1210 FOURIER DR
Suite 100
MADISON WI 53717