

US. PUBLIC LAND SURVEY MONUMENT RECORD

Hazel Green T.



CORNER DESCRIPTION: NECORNER, SECTION 13, T 1 N, R 1 W
 STATE PLANE COORDINATES: N _____, E _____
 THETA ANGLE: _____
 HORIZONTAL DATUM: WISCONSIN STATE PLANE COORDINATE SYSTEM, SOUTH ZONE

MAY 14 1986

EVIDENCE: FOUND 5"x15" STONE (SET "X" IN TOP)

MONUMENT: FOUND , PLACED
 METHOD OF RESTORATION (RE-ESTABLISHMENT):
 ACCEPTED EXISTING MONUMENT
 ACCEPTED OCCUPATION
 LOST CORNER PROPORTIONATE METHODS
 DATE CORNER SET: _____

- LEGEND
- ▲ SET #6 REBAR, 113 LBS PER LINEAL FT. MIN. WT
 - SET 1"x24" IRON PIPE, 113 LBS PER LINEAL FT. MIN. WT
 - SET 2"x30" IRON PIPE, 365 LBS. PER LINEAL FT. MIN. WT
 - FOUND 1" IRON PIPE
 - FOUND 2" IRON PIPE
 - FOUND R/R SPIKE
 - SET R/R SPIKE
 - ⊙ GOVERNMENT CORNER
 - EXISTING FENCE

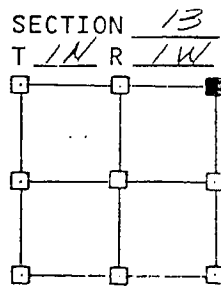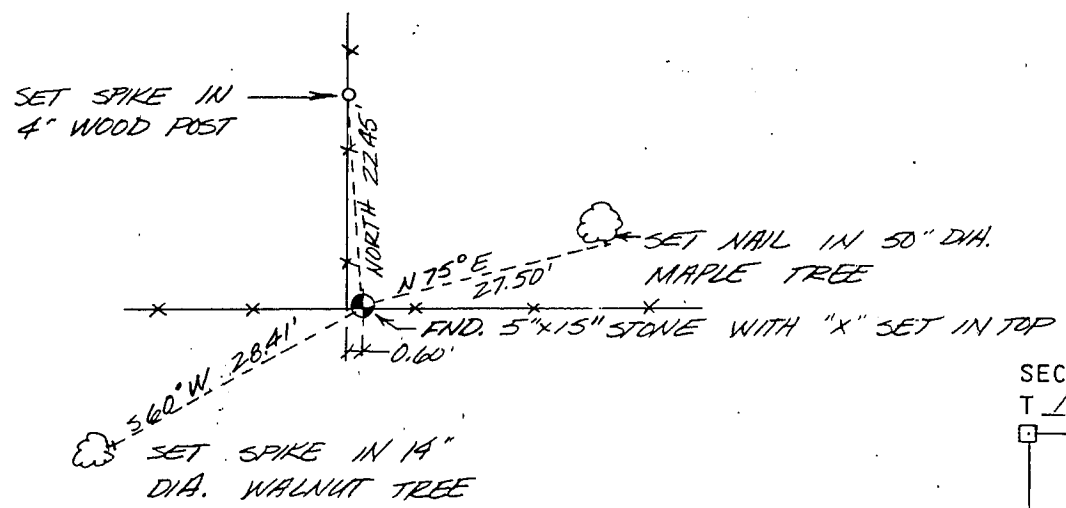


NOT TO SCALE THIS CONFORMS TO WISCONSIN ADMINISTRATIVE CODE A-E 5.02

SURVEYOR'S AFFIDAVIT:
 STATE OF WISCONSIN)
GRANT COUNTY) SS

I hereby certify that I, DOUGLAS J. MALLICK, have complied with the Wisconsin State Statutes, Statutes of the United States, and the rules and regulations made by the Secretary of the Interior in the location of the corner shown above.

DATE OF SURVEY: APRIL 12, 1986
Douglas J. Mallick
 REGISTERED LAND SURVEYOR
 # 1266

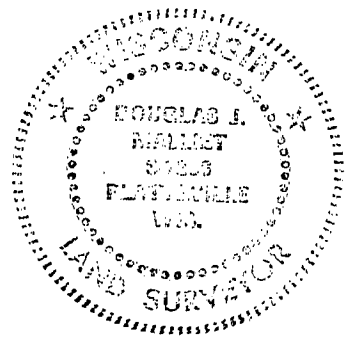

D. F. BURBACH MUNICIPAL & CIVIL ENGINEERS
 410 NORTH SECOND STREET • PLATTEVILLE, WISCONSIN 53818 • (608) 348-3262