


Survey Monument Record

CORNER NO. 59
SECTION 13
TOWN 1 N
RANGE 1 W

TYPE OF MONUMENT 3/4" X 24" Iron Rod
DATE PLANE COORDINATES: N _____
E _____
ELEVATION — M.S.L. DATUM: _____
BETA ANGLE: _____
FIELD BOOK: _____
PAGE _____

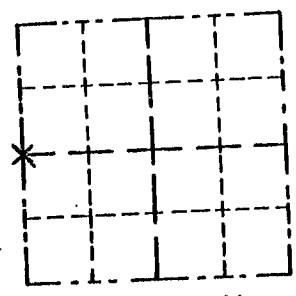

LOCATION
(Indicated by "X")

BASIS FOR MONUMENT LOCATION

(See reverse side if necessary)
Show info such as: History of corner, with reference to Vol. and pg., dates, surveyor; exact description of monument replaced; if location computed, by taped or EDM traverse; and owner, remarks, etc.

SEAL:

MONUMENT SET FROM EXISTING SURVEY AND FIELD EVIDENCE AFTER EXAMINATION OF THE ORIGINAL SURVEY PLAT AND FIELD NOTES AFTER A FIELD EDM SURVEY OF THE SECTION.


CERTIFIED CORRECT

Thomas Buick
Registered Land Surveyor

DATE: 2/5/90

TIE SKETCH

Show at least three (3) ties and monument

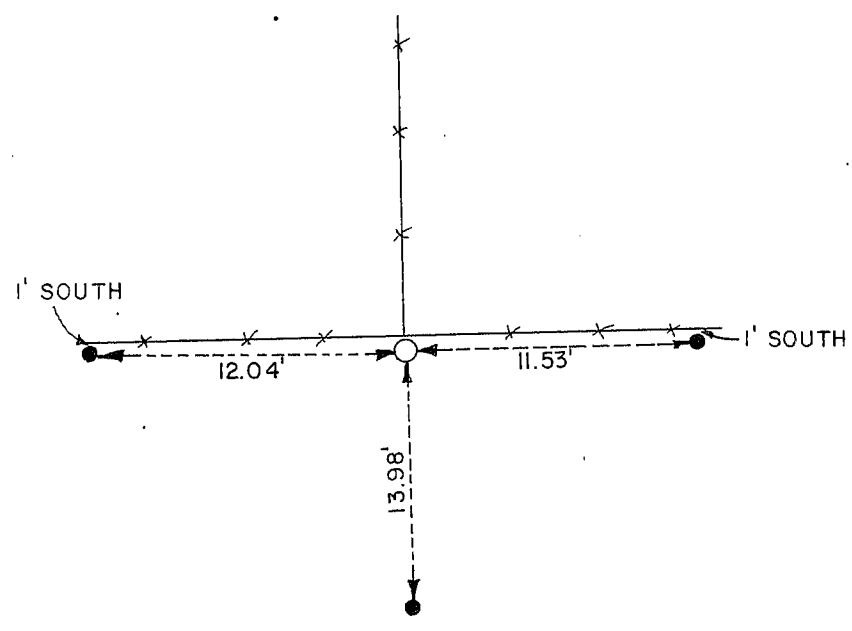

- = 3/4" X 24" IRON ROD
- = 5/8" X 18" IRON ROD
- * * = EXISTING FENCE