


# U.S. PUBLIC LAND SURVEY MONUMENT RECORD

Section 31, Town 1 North Range 1 West, Town of Hazel Green, Grant County, Wisconsin

## CERTIFICATE

I, Larry L. Austin, do hereby certify that the corner location on this record was determined by me and/or under my direct supervision and that this U.S. public land survey monument record is correct and complete to the best of my knowledge and belief.

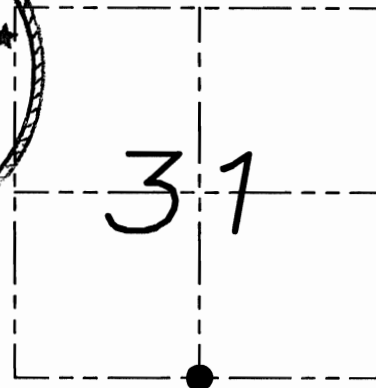

● = CORNER LOCATION

*Larry L. Austin* 6.8.09  
 Larry L. Austin, S-1903 date

## HISTORY OF CORNER

Corner was originally set in the 2nd quarter of 1832 by Lyon. No other recent record of the corner was found.

## CORNER EVIDENCE FOUND


I reset the corner on-line with an existing fence North for Easting. Northing was established on-line between the Southwest and Southeast corners of Section 31. Verified this location using EDM & GPS methods.

**DESCRIPTION OF CORNER AND WITNESS MONUMENTS**, references and accessories used to perpetuate the original or re-established location of this corner. Witnesses to monument location Bobby Sedgwick & Brad Digman & Shelby Blindert

## SKETCH:

### LEGEND

- ⊕ Number 8 x 30" rebar set
- Number 4 x 24" Rebar set with red plastic "TIE" cap
- x- Approximate existing fence

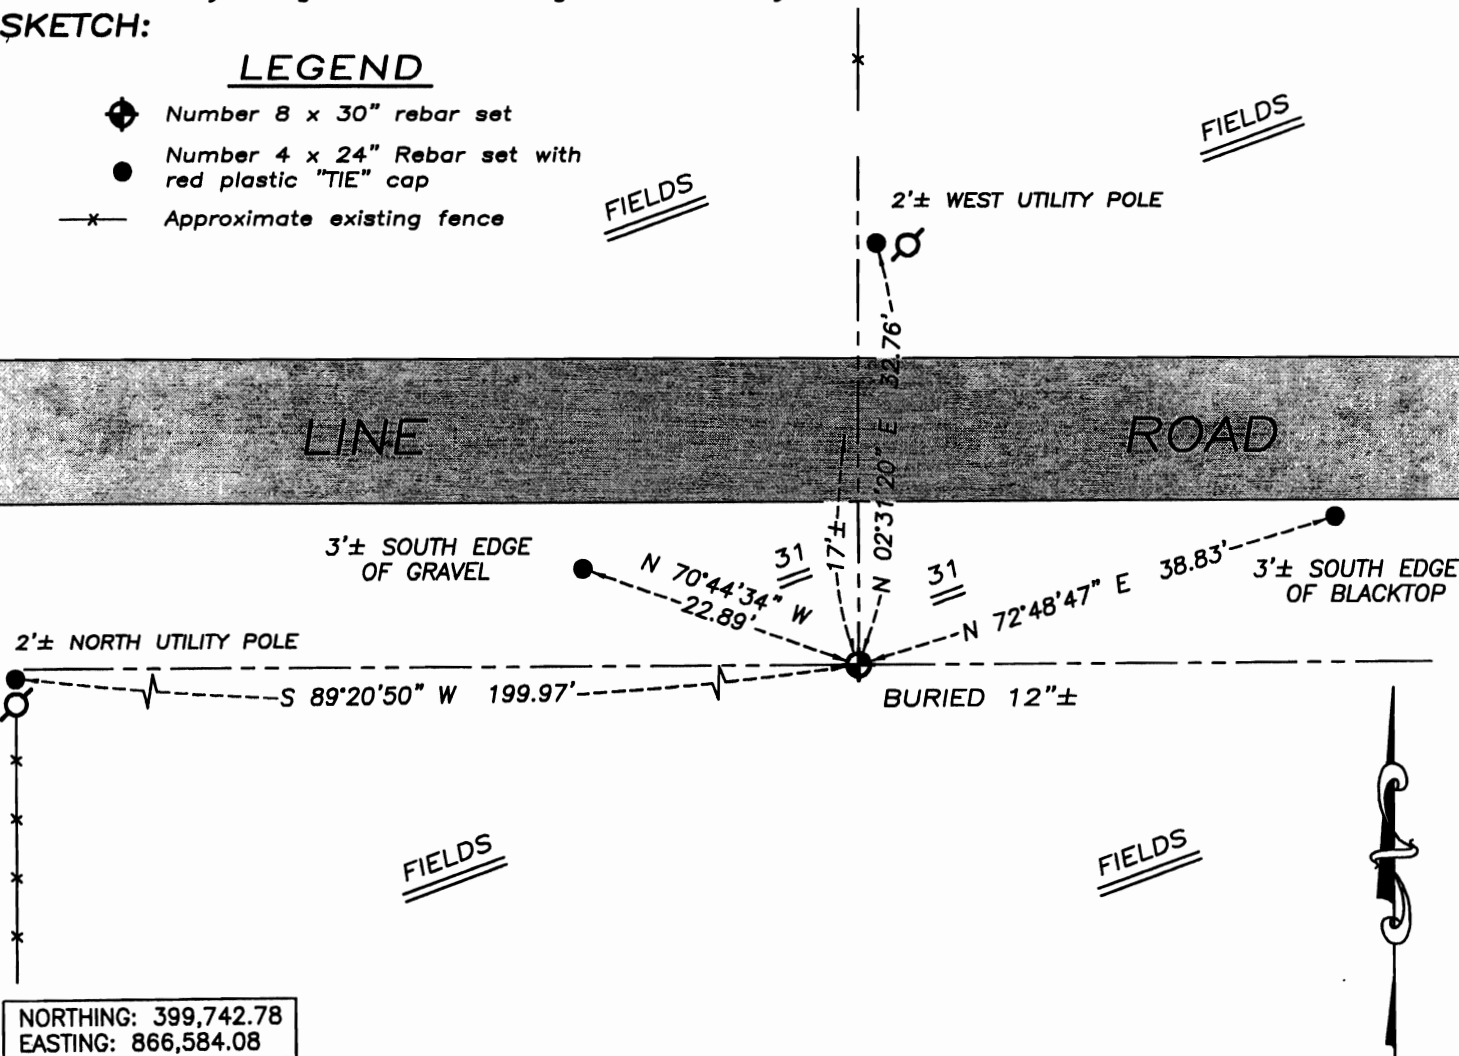

NORTHING: 399,742.78  
 EASTING: 866,584.08

**Austin Engineering LLC**  
 4211 HWY 81 E, LANCASTER, WI 53813  
 PHONE 608-723-6363 FAX 608-723-6702

JOB NUMBER 08S002  
 FIELDBOOK: TDSR, 2910  
 G:\T1NR1W\T1NR1W  
 H:\TIE\T1NR1W\132

DRAWN BY: SW AUSTIN  
 APPROVED: LL AUSTIN

NOT TO SCALE