


U.S. PUBLIC LAND SURVEY MONUMENT RECORD

Section 32, Town 1 North Range 1 West, Town of Hazel Green, Grant County, Wisconsin

CERTIFICATE

I, Larry L. Austin, do hereby certify that the corner location on this record was determined by me and/or under my direct supervision and that this U.S. public land survey monument record is correct and complete to the best of my knowledge and belief.

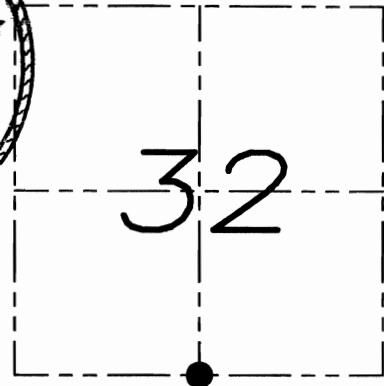

● = CORNER LOCATION

Larry L. Austin 6.8.09
 Larry L. Austin, S-1903 date

HISTORY OF CORNER

Corner was originally set in the 2nd quarter of 1832 by Lyon. In 1851 Everett tied to the corner. In 1854 Overton tied to the corner. In 1999 Rossman set a No. 6 iron bar. In 2001 Bradshaw found a 1" iron bar. In 2008 Austin found a 1" iron bar.

CORNER EVIDENCE FOUND

I found the No. 8 iron bar and accepted it's location after an EDM & GPS traverse of the area.

DESCRIPTION OF CORNER AND WITNESS MONUMENTS, references and accessories used to perpetuate the original or re-established location of this corner. Witnesses to monument location Bobby Sedgwick & Brad Digman & Shelby Blindert

SKETCH:



LEGEND

- ◻ No. 8 rebar found
- Number 4 x 24" Rebar set with red plastic "TIE" cap
- x- Approximate existing fence

NORTHING: 399,718.53
 EASTING: 871,868.30

Austin Engineering LLC

4211 HWY 81 E, LANCASTER, WI 53813
 PHONE 608-723-6363 FAX 608-723-8702

JOB NUMBER OBS002
 FIELDBOOK: TDSR, 2910
 G:\T1NR1W\T1NR1W
 H:\TIE\T1NR1W\130

DRAWN BY: SW AUSTIN
 APPROVED: LL AUSTIN

NOT TO SCALE