

SECTION CORNER TIES

TO THE NORTHWEST CORNER OF SECTION 16, TOWN 1 NORTH,
RANGE 2 WEST, FOURTH PRINCIPLE MERIDIAN, JAMESTOWN
TOWNSHIP, GRANT COUNTY, WISCONSIN.


Jamestown

I, Bruce D. Bowden, hereby certify that I have
complied with the Wisconsin Statutes, the Statutes
of the United States and the rules and regulations
of the Secretary of the Interior in the location of
the corner shown below.

April 24, 1978




Bruce D. Bowden
Bruce D. Bowden R.L.S.-1250

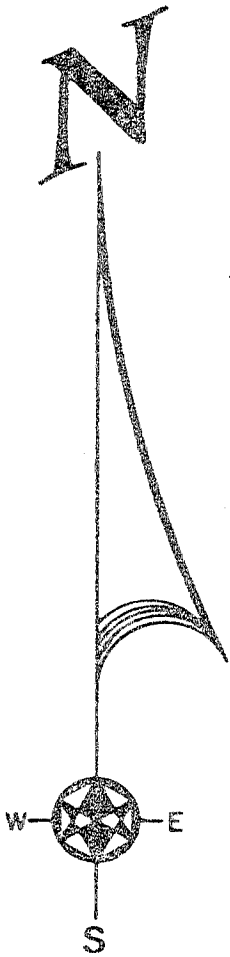
Corner set from existing physical
evidence and checked with
proportionate measure.



STATE PLANE COORDINATES:
NORTH 206852.224
EAST 1832294.214

LEGEND

-  4" x 30" Cast Aluminum Monument (at grade)
-  3/4" x 24" Iron Rod
-  Large wooden set posts

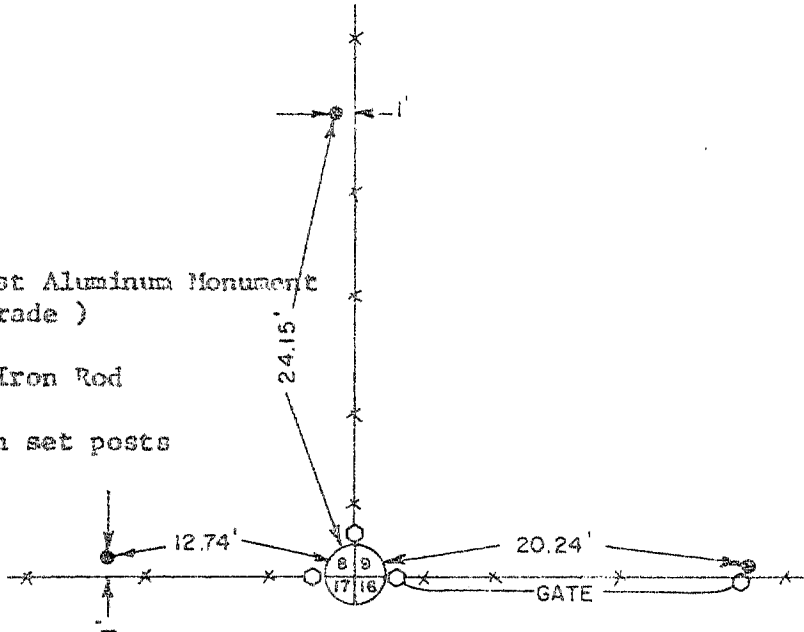

BOOK D-1 PAGE 47
JOB NO. D-78007
CHECKED _____
DRAWN BY RJM

SCALE: 1" = 10'

TALARCZYK & ASSOC., INC.

110 E. Division Street
DODGEVILLE, WI 53533

Phone 608/935-5301