


Survey Monument Record

CORNER NO. 65
SECTION 23
TOWN 1N
RANGE 2W

TYPE OF MONUMENT 1" IRON PIPE

FOUND

FIELD BOOK: 96-20
PAGE (17)

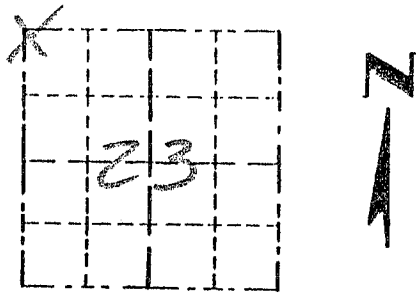

LOCATION
(Indicated by "X")


BASIS FOR MONUMENT LOCATION

(Use reverse side if necessary)

Show info such as: History of corner, with reference to Vol. and pg. dates, surveyor; exact description of monument replaced; if location computed, by taped or EDM traverse; landowner, remarks, etc.

SEAL:

CORNER SET IN 1832
BY LUCIUS LYON. NO
RECORD OF CORNER
FOUND SINCE ORIGINAL
SURVEYS. I FOUND AND ACCEPTED A
1" IRON PIPE AT AN
OCCUPIED FENCE CORNER.
VERIFIED ITS LOCATION
USING EDM METHODS.

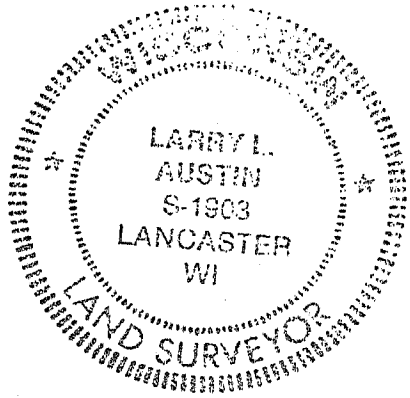

CERTIFIED CORRECT

Larry L. Austin
Registered Land Surveyor

DATE: 12/24/97

TIE SKETCH

Show at least three (3) ties and monument

LEGEND

- 1" IRON PIPE SET
- 1/2" X 15" IRON BAR SET
- *** EXISTING FENCE

