

U. S. PUBLIC LAND SURVEY MONUMENT RECORD

INSTRUCTIONS: This record shall show the location of the corner and shall include all of the following nine elements (a through i).


- (a) Identify the corner by reference to the U.S. public land survey system.
 ● = Corner monument restored.

W1/4 Corner of Section 19

T1N R1W

Town of HAZEL GREEN

Grant County, Wi.

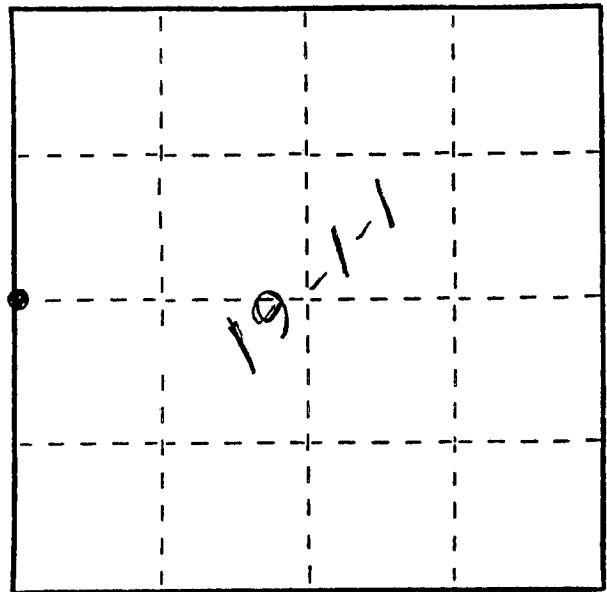


- (b) Describe any record evidence, monument evidence, occupational evidence, testimonial evidence or any other material evidence you considered, and whether the monument was found or placed.

Original corner set by Lucius Lyon in 1832. In September 1879 Jack Barber, surveyor, surveyed the SW1/4 of Section 19. He set a rock at the 40 corner to the East, and called an "Ancient rock corner" at the center of section. He does not indicate he set anything at the W1/4 corner, calling it the original, "indicated by fencing and voluched for by Joseph Sparks". Did not find the rock at the 40 corner, and the center of section is now occupied by CTH Z. Lacking occupation at adjacent 40 corners, accepted the old fence corner as the best evidence, and so placed.


- (c) In the plan view drawing below, provide reference ties to at least 4 witness monuments, or, if the location is within a municipality, to at least 2 witness monuments. (Witness monuments shall be made of concrete, natural stone, iron or other equally durable material.) Describe witness monuments.

- (d) Show a plan view drawing depicting the relevant monuments and reference ties which is sufficient in detail to enable accurate relocation of the corner monument if the corner monument is disturbed. Indicate north.

(Road width not shown to scale)

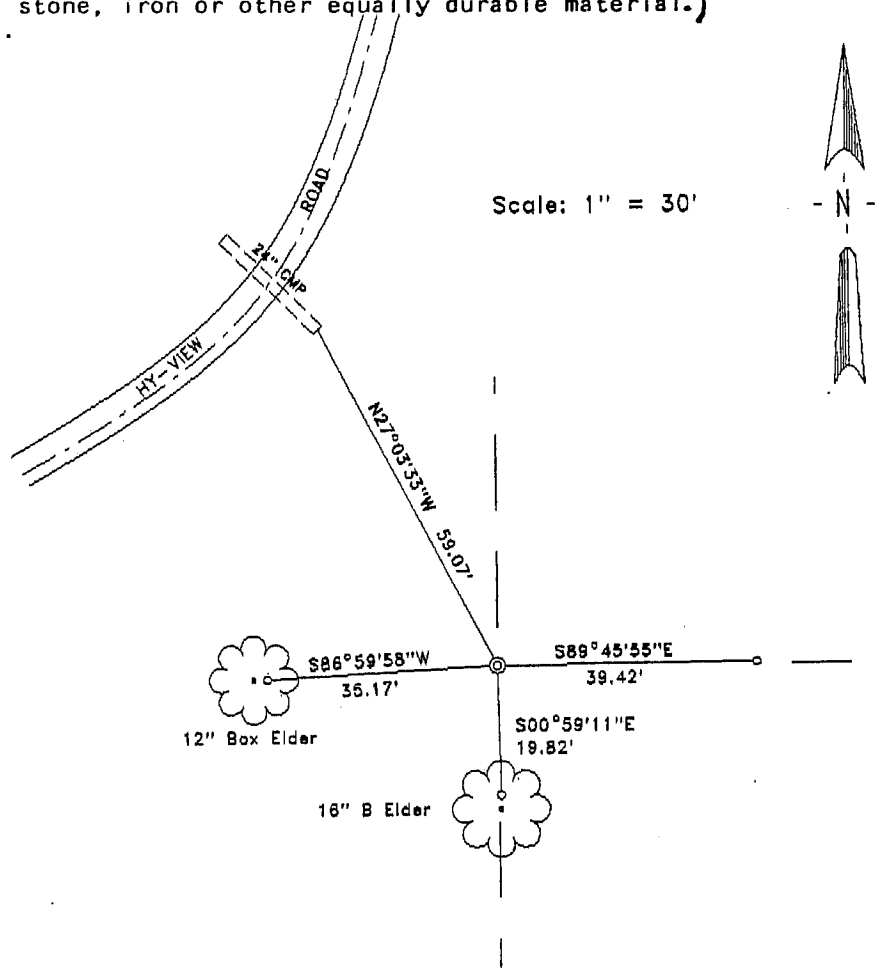

Scale: 1" = 30'

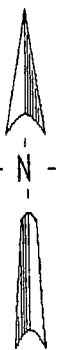

- 3/4" X 30" Rebar set
- ◎ Corner Monument is 2" X 30" WI. D.O.T. Aluminum Monument with sign and post

(e) Describe any material discrepancy between the location of the corner as restored or reestablished and the location of that corner as previously restored or reestablished by distance and direction. Show the discrepancy on the plan view drawing under (d), above. Show the distances between the corner as previously restored or reestablished and (1) the corner as restored or reestablished, and (2) to at least 2 of the witness monuments shown on the drawing in (d), above.

None


(f) Was the corner restored through acceptance of (1) an obliterated evidence location, or, (2) a found perpetuated location?

(Accepted Occupation)

(g&h) Was the corner reestablished through lost corner proportionate methods? If so, show the method, including the directions and distances to other public land survey corners used as evidence or used for proportioning in determining the corner location?

No

Affix Land Surveyor Seal

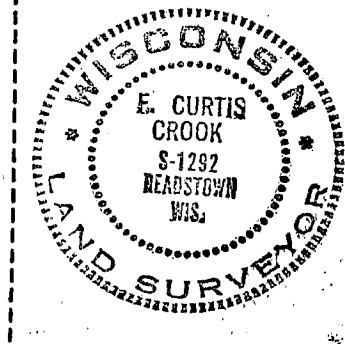

(i) I, F. Curtis Crook
(type or print name) certify that the corner location shown on this record was determined by me or under my direction and control and that this U.S. Public Land Survey Monument Record is correct and complete to the best of my knowledge and belief.

F. Curtis Crook 1-14-96