


U.S. PUBLIC LAND SURVEY MONUMENT RECORD

Section 31, Town 1 North Range 1 West, Town of Hazel Green, Grant County, Wisconsin

CERTIFICATE

I, Larry L. Austin, do hereby certify that the corner location on this record was determined by me and/or under my direct supervision and that this U.S. public land survey monument record is correct and complete to the best of my knowledge and belief.

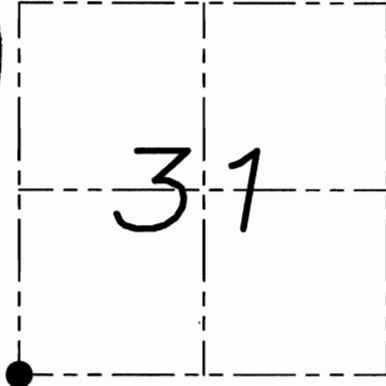

● = CORNER LOCATION

Larry L. Austin 6-8-09
 Larry L. Austin, S-1903 date

HISTORY OF CORNER

Corner was originally set in the 2nd quarter of 1832 by Lyon. No other record of the corner was found.

CORNER EVIDENCE FOUND

After excavating with a backhoe, no evidence of the corner was found. I reset the corner proportionately between adjoining corners. Verified this location using EDM & GPS methods.

DESCRIPTION OF CORNER AND WITNESS MONUMENTS, references and accessories used to perpetuate the original or re-established location of this corner. Witnesses to monument location Bobby Sedgwick & Brad Digman & Shelby Blindert

SKETCH:

2'± SOUTH 24" COTTONWOOD

YARD

YARD

LEGEND

- ◆ Number 8 x 30" rebar set with Grant County Aluminum cap
- Number 4 x 24" Rebar set with red plastic "TIE" cap
- x- Approximate existing fence



LINE

ROAD

5'± SOUTH OF MAILBOXES

LIMITS OF EXCAVATION

FIELDS

FIELDS

NORTHING: 399,749.78
 EASTING: 863,940.14

NOT TO SCALE

Austin Engineering LLC

JOB NUMBER 08S002
 FIELDBOOK: TDSR, 2910
 G:\T1NR1W\T1NR1W
 H:\TIE\T1NR1W\133

DRAWN BY: SW AUSTIN
 APPROVED: LL AUSTIN

4211 HWY 81 E, LANCASTER, WI 53813
 PHONE 608-723-6363 FAX 608-723-6702