

GRANT COUNTY

Survey Monument Record

TYPE OF MONUMENT 3/4" X 24" IRON ROD SET

STATE PLANE COORDINATES: N W/ CAP.
E _____


ELEVATION — M.S.L. DATUM: _____

THETA ANGLE: _____

FIELD BOOK: 96-04

PAGE _____

CORNER NO. 17
SECTION 3
TOWN 2N
RANGE 1W

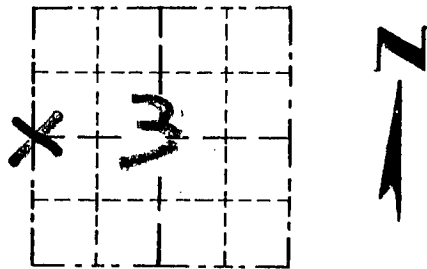


LOCATION
(Indicated by "X")

BASIS FOR MONUMENT LOCATION

(Use reverse side if necessary)

ORIGINAL CORNER SET IN 1832 BY LUCIUS LYON. I SET THE CORNER ON LINE BETWEEN NW CORNER & THE SW CORNER OF SEC 2 & AT AN OCCUPIED LOCATION N-S. (THE TOWNSHIP ROAD HAS A BOW IN IT IN THIS AREA.) THIS LOCATION FITS BETTER THAN USING PROPORTIONING N-S.

SEAL:

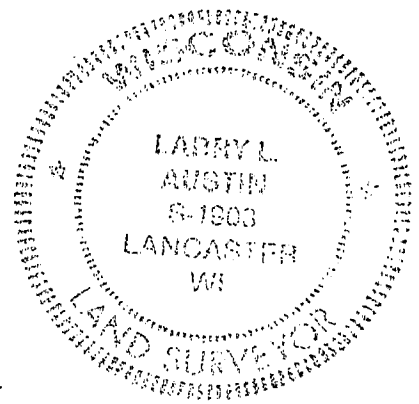

CERTIFIED CORRECT

Larry L. Austin
Registered Land Surveyor

DATE: 5-7-96

TIE SKETCH

Show at least three (3) ties and monument

LEGEND

- ⊙ 3/4" X 24" IRON BAR SET W/ CAP
- 1/2" X 15" IRON BAR SET
- xx EXISTING FENCE
- ⊖ POWER POLE

