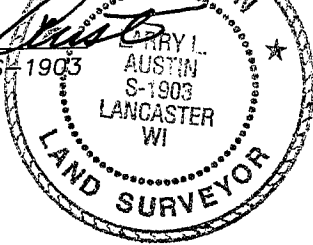



U.S. PUBLIC LAND SURVEY MONUMENT RECORD – GRANT COUNTY, WI
Section 6, Town 2 North Range 1 West, Town of Smelser

CERTIFICATE

I, Larry L. Austin, do hereby certify that the corner location on this record was determined by me and/or under my direct supervision and that this U.S. public land survey monument record is correct and complete to the best of my knowledge and belief.

Dated this 30th day of December, 2005

Larry L. Austin
 Larry L. Austin S-1903

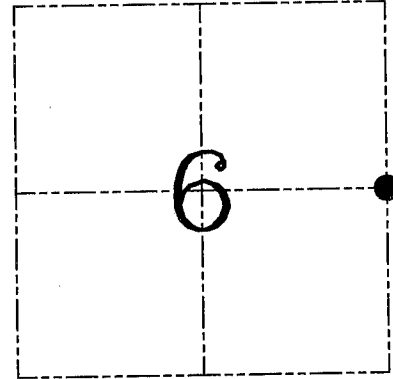 LAND SURVEYOR



● = CORNER LOCATION

HISTORY OF CORNER ESTABLISHMENT

Corner was originally set in 1832 by Lyon.
 In 1994 I set and tied this corner.




DESCRIPTION OF CORNER EVIDENCE FOUND


I found and accepted the corner location. Witness monuments were lost. I set new ties as shown below. Verified this location using EDM & GPS methods.

DESCRIPTION OF CORNER AND WITNESS MONUMENTS, references and accessories used to perpetuate the original or re-established location of this corner. Witnesses to corner location Bobby Sedgwick & Brad Digman & Shane Austin

SKETCH:

LEGEND

-  1 1/2" diameter iron pipe found
-  Number 4 x 24" Rebar set with red plastic "TIE" cap
-  Approximate existing fence

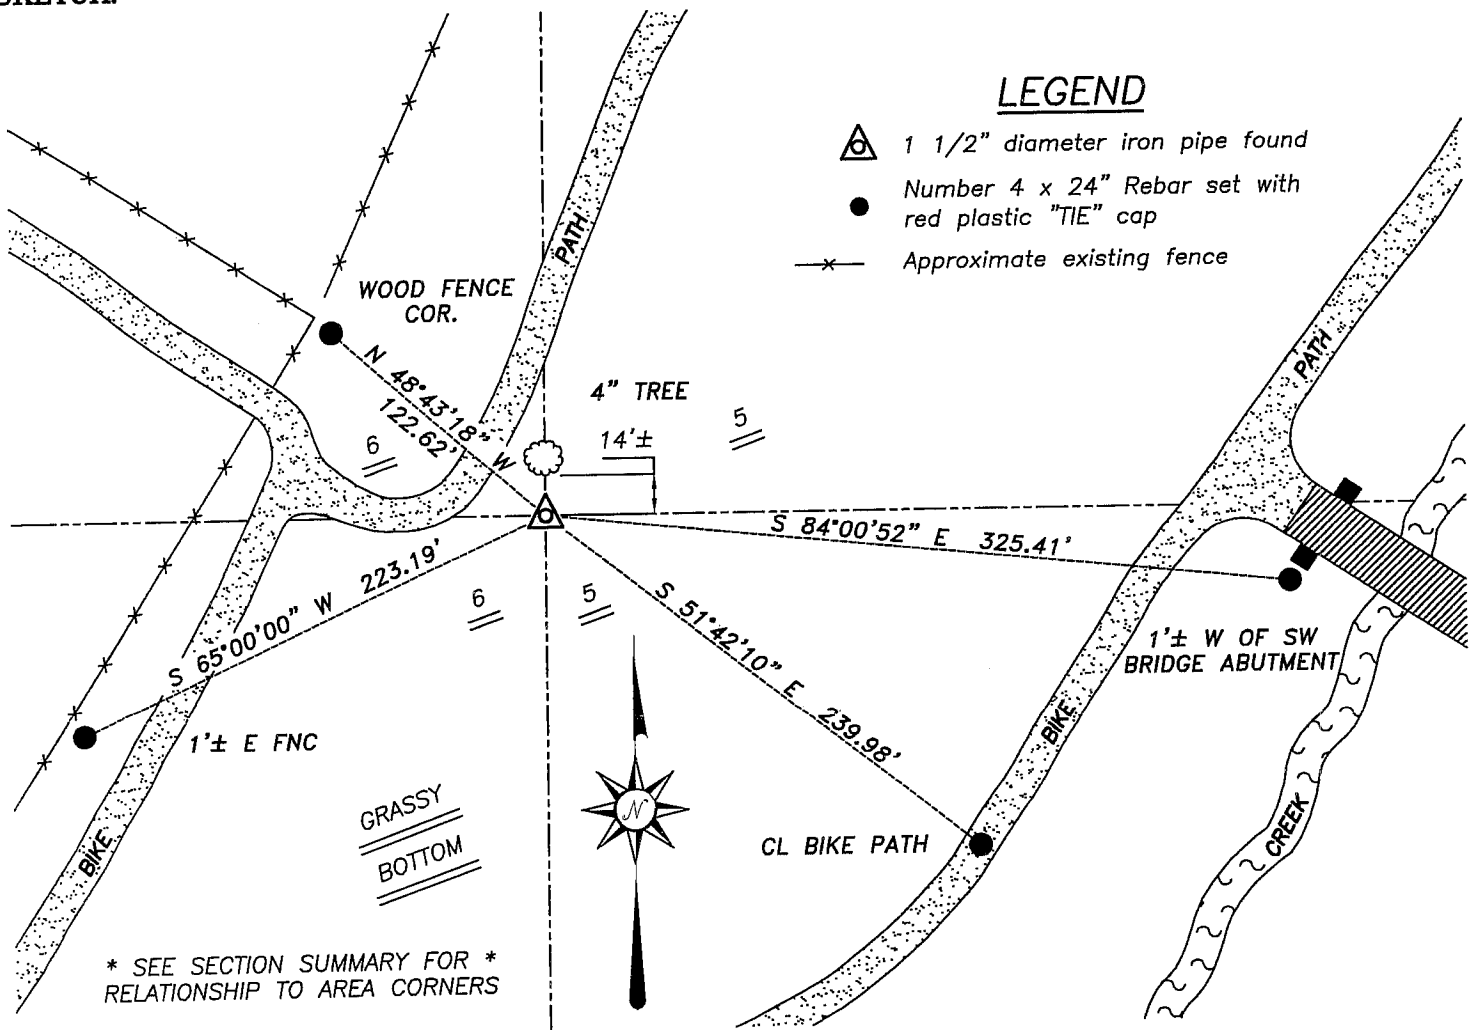

* SEE SECTION SUMMARY FOR *
 RELATIONSHIP TO AREA CORNERS

SKETCH NOT TO SCALE



Austin
Engineering LLC

4211 HWY 81 E, LANCASTER, WI 53813
 PHONE 608-723-6363 FAX 608-723-6702

JOB NUMBER: 03S047
 FIELDBOOK: TDSR, 2309
 G:\T2NR1W\06
 H:\TIE\T2NR1W\15

DRAWN BY: ML DIGMAN
 APPROVED: LL AUSTIN


GRANT COUNTY

Survey Monument Record

TYPE OF MONUMENT 1 1/2" O.D. ROUND IRON PIPE
 STATE PLANE COORDINATES: N _____
 E _____
 ELEVATION — M.S.L. DATUM: _____
 THETA ANGLE: _____
 FIELD BOOK: 9105A
 PAGE 30

CORNER NO. 15
 SECTION 5
 TOWN Z N
 RANGE 1 W

W 1/4 CORNER

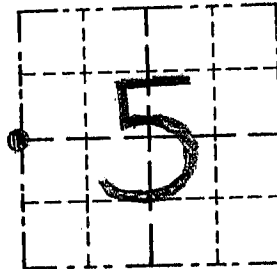


LOCATION
(Indicated by "●")

BASIS FOR MONUMENT LOCATION


(Use reverse side if necessary)

Show info such as: History of corner, with reference to Vol. and pg., dates, surveyor; exact description of monument replaced; if location computed, by taped or EDM traverse; landowner, remarks, etc.

NO RECORD OF CORNER FOUND SINCE THE ORIGINAL SURVEYS; I SET THE CORNER ON LINE AT THE RECORDED DISTANCE FROM THE SW CORNER.

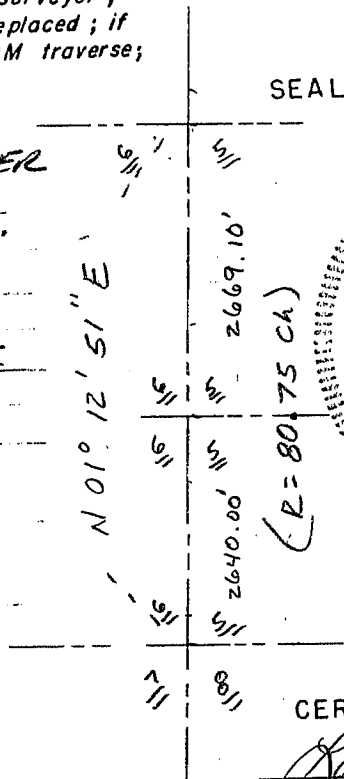

SEAL:

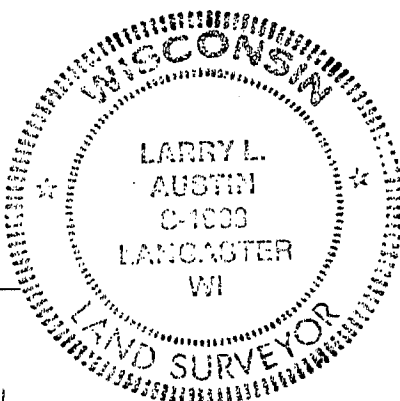

CERTIFIED CORRECT

Larry L. Austin
 Registered Land Surveyor

DATE: 6/12/94

TIE SKETCH

Show at least three (3) ties and monument

