

GRANT COUNTY

Survey Monument Record

TYPE OF MONUMENT COUNTY MONUMENT

STATE PLANE COORDINATES: N _____
E _____


ELEVATION — M.S.L. DATUM: _____

THETA ANGLE: _____

FIELD BOOK: 94-18

PAGE 27

CORNER NO. 51
SECTION 17
TOWN 2 N
RANGE 1 W
NW COR.

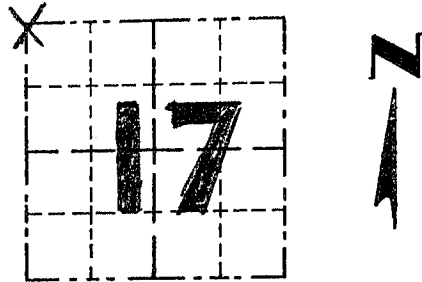

LOCATION
(Indicated by "X")


BASIS FOR MONUMENT LOCATION

(Use reverse side if necessary)

Show info such as: History of corner, with reference to Vol. and pg., dates, surveyor; exact description of monument replaced; if location computed, by taped or EDM traverse; landowner, remarks, etc.

SEAL:

CORNER ORIGINALLY SET IN 1832 BY LUCIUS LYON; NO RECORD FOUND OF CORNER SINCE ORIGINAL SURVEYOR; I SET THE CORNER ON LINE WITH FOUND FENCE REMNANTS & 10 CHAINS E. OF THE NW CORNER OF THE NE¹/₄, NE¹/₄, NE¹/₄ OF SEC. 18; THIS LOCATION FITS WELL WITH OTHER CORNERS IN THE AREA; VERIFIED BY EDM TRAVERSE

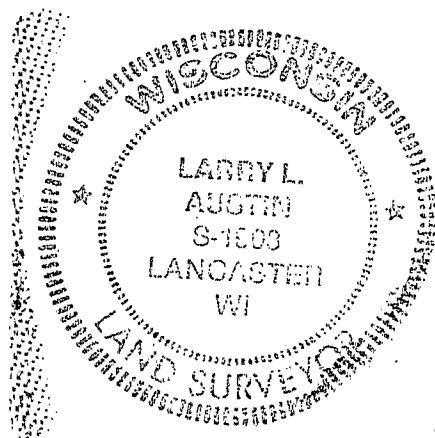

CERTIFIED CORRECT

Larry L. Austin
Registered Land Surveyor

DATE: 3/9/95

TIE SKETCH

Show at least three (3) ties and monument

LEGEND

- ⊕ GRANT COUNTY ALUMINUM MONUMENT SET = CORNER
- 1" IRON PIPE SET = TIE
- 3/4" IRON BAR SET = TIE
- ⊗ 26±" DIA TREE W/ WIRE THROUGH CENTER
- ×× EXISTING FENCE

