


GRANT COUNTY

Survey Monument Record

TYPE OF MONUMENT GRANT CO. ALUM. MON
 STATE PLANE COORDINATES: N _____
 E _____
 ELEVATION — M.S.L. DATUM: _____
 THETA ANGLE: _____
 FIELD BOOK: 94-18
 PAGE 11

CORNER NO. 36
 SECTION 9
 TOWN 2 N
 RANGE 1 W
W 1/4 COR.

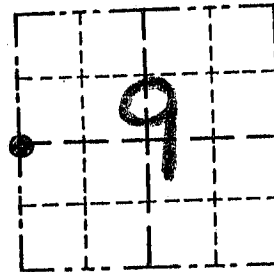

LOCATION
 (Indicated by "●")


BASIS FOR MONUMENT LOCATION

(Use reverse side if necessary)

Show info such as: History of corner, with reference to Vol. and pg., dates, surveyor; exact description of monument replaced; if location computed, by taped or EDM traverse; landowner, remarks, etc.

SEAL:

NO RECORD OF CORNER
FD. SINCE ORIGINAL SURVEYS
LOCATED THE CORNER BASED
OCCUPATIONAL EVIDENCE &
VERIFIED BY EDM TRAVERSE
OF THE AREA

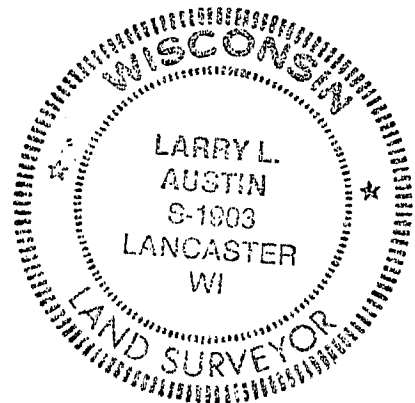

CERTIFIED CORRECT

Larry L. Austin
 Registered Land Surveyor

DATE: 10/28/94

TIE SKETCH

Show at least three (3) ties and monument

