

RECORD OF U.S. PUBLIC LAND SURVEY CONTROL STATION

QUARTER SECTION CORNER  $\frac{13}{24} \frac{13}{24}$  TOWNSHIP 2 N, RANGE 1 W; GRANT COUNTY, WISCONSIN

GEODETIC SURVEY BY: \_\_\_\_\_  
 STATE PLANE COORDINATES OF: \_\_\_\_\_  
 NORTH \_\_\_\_\_  
 EAST \_\_\_\_\_

ELEVATION OF STATION: \_\_\_\_\_ THETA ANGLE: \_\_\_\_\_




HORIZONTAL DATUM: WISCONSIN STATE PLANE COORDINATE SYSTEM, SOUTH ZONE




VERTICAL DATUM: MEAN SEA LEVEL, 1929 ADJUSTMENT

HORIZONTAL & VERTICAL CONTROL ACCURACY: SECOND ORDER

LOCATION SKETCH:

LEGEND:

-  No Corner Set.
-  1-1/4" x 30" Solid Rd. Iron Rod Set, Weigh. 4.3 Lbs./Lineal Ft.
-  Right-of-Way Post.

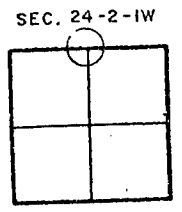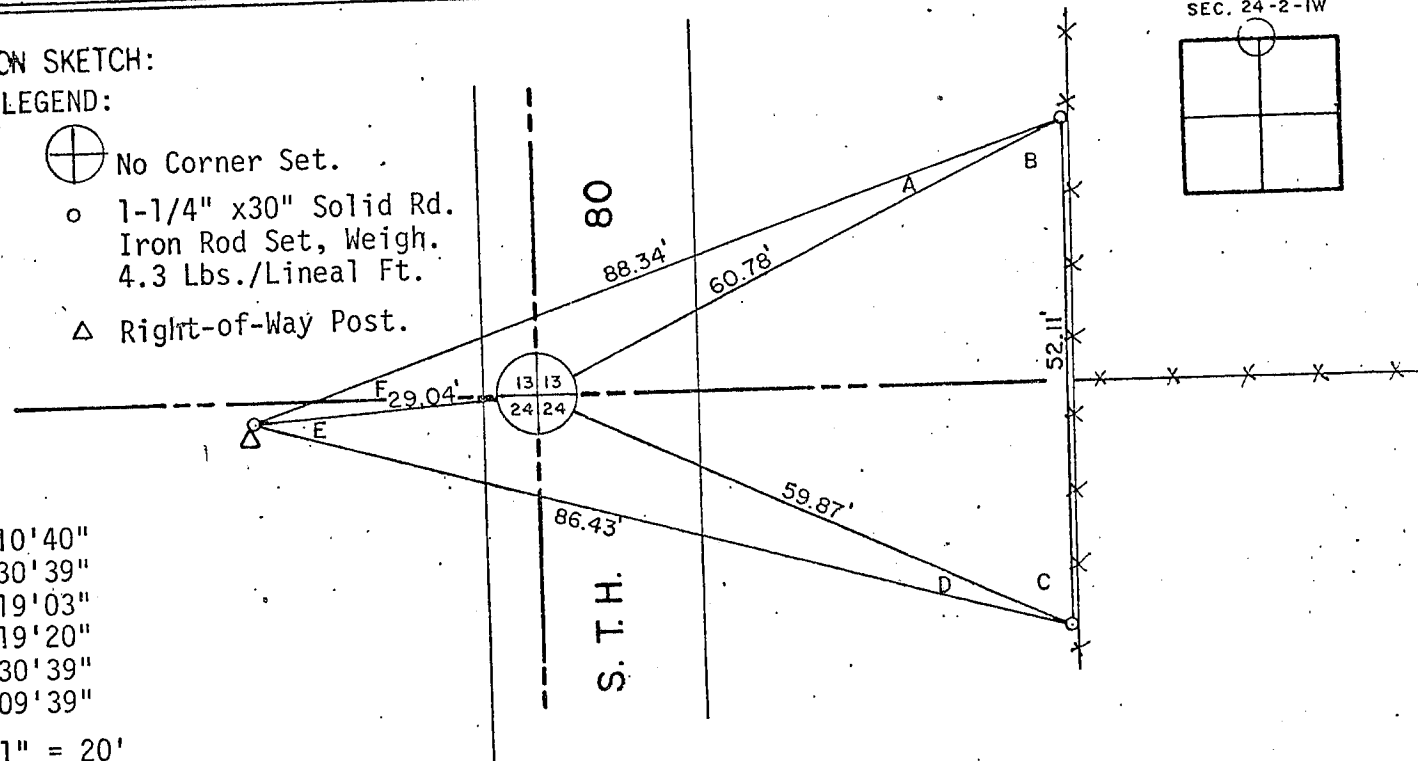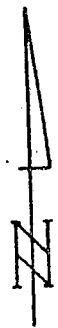

ANGLES:

- A 7°10'40"
- B 63°30'39"
- C 65°19'03"
- D 9°19'20"
- E 19°30'39"
- F 15°09'39"


SCALE: 1" = 20'

SURVEYOR'S AFFIDAVIT:

STATE OF WISCONSIN)  
 GREEN COUNTY) SS

I HEREBY CERTIFY THAT I, Richard D. Talarczyk, have complied with the Wisconsin Statutes, Statutes of the United States, and the rules and regulations made by the Secretary of the Interior in the location of the corner shown above.

DATE OF SURVEY: 8-29-81 to 9-17-81 *Richard D. Talarczyk*  
 Richard D. Talarczyk

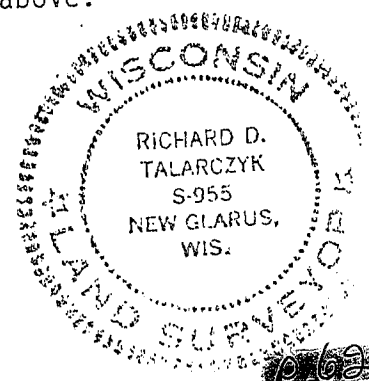

SEP 24 1981