


GRANT COUNTY

Survey Monument Record

TYPE OF MONUMENT 3/4" IRON BAR
 STATE PLANE COORDINATES: N _____
 E _____
 ELEVATION — M.S.L. DATUM: _____
 THETA ANGLE: _____
 FIELD BOOK: 94-18
 PAGE 27

CORNER NO. 55
 SECTION 17
 TOWN 2N
 RANGE 1W
W 1/4 COR

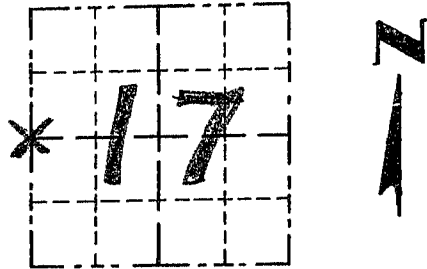

LOCATION
 (Indicated by "X")


BASIS FOR MONUMENT LOCATION

(Use reverse side if necessary)

Show info such as: History of corner, with reference to Vol. and pg., dates, surveyor; exact description of monument replaced; if location computed, by taped or EDM traverse; landowner, remarks, etc.

SEAL:

NO RECORD FOUND OF CORNER SINCE ORIGINAL 1832 SURVEY BY LUCIUS LYON. CORNER WAS REESTABLISHED BASED ON OCCUPATIONAL EVIDENCE AND VERIFIED BY EDM TRAVERSE OF THE AREA.

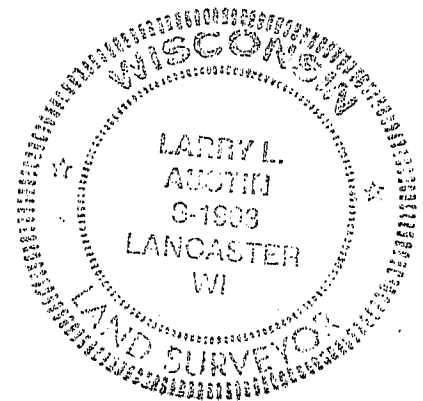

CERTIFIED CORRECT

Larry L. Austin
 Registered Land Surveyor

DATE: 3/9/95

TIE SKETCH

Show at least three (3) ties and monument

